

SURVEY &
REMONUMENTATION

JUL 06 1998

MECOSTA COUNTY REMONUMENTATION PROGRAM

CORNER APPROVED BY PEER GROUP ON February 13, 1998

SECTION

LAND CORNER RECORDATION CERTIFICATE

Filing Requirement of Act 74, Mich. P.A. 1970

REGISTER'S OFFICE }
Mecosta County, } ss.

For corners in

Mecosta

(County)

Located In:

BIG RAPIDS TWP.

Corner Code #

1. Public Land Survey SEC 28 T 15N R 10W
T R
T R
T R
T R
2. Property Controlling S T R
in Section S T R
3. Miscellaneous S T R
Property in Sec. S T R

E-9

Received for Record, the 29
day of June A.D., 1998
at 3:15 o'clock P.M., and Recorded
in Liber _____ of _____
on Page _____

Register of Deeds

Register of Deeds
Mecosta County

Register of Deeds Stamp & File Number

4. Lot No. _____, Recorded Plat _____

5. Private Claims _____

I, James J. Keller, in a field survey on FEBRUARY 11, 19 98,
do hereby certify that under requirements of P.A. 74, Michigan P.A. of 1970, the corner points mentioned
in lines 1 and 2 above were in conformance with regulations and rules therefore as required in the
current manual of survey instructions of the United States Department of the Interior, Bureau of Land
Management or by a decree of a Court of Law and/or that the corner points mentioned in lines 3, 4 and 5
above were in conformance with the rules of the Michigan Board of Land Surveyors or by a Decree of a
Court of Law; established, re-established, monumented, re-monumented, recovered, found as
expressed below:

NOTE: Not more than 2 corners, all in the same town and range, may be recorded
on this certificate.

A. Description of original monument and accessories and/or subsequent restoration:

February 14, 1838, Abner E. VanNess, Deputy Surveyor G.L.O. "Set Post Cor. to Sect. 20, 21, 28 & 29"
6" Beech N85-1/2°W 5 Links (3.30') 10" Beech S44-1/2°E 27 Links (17.82)

December 26-27-28, 1935, W.H. Wright, Mecosta County Road Survey "Sec. Cor. stone Mound & Glass"

April 22, 1938, W.H. Wright, Mecosta County Road Survey "Sec. Cor. Iron Bar"
8" Maple SW 31.2' 16" Maple NE 78.1'

July 9, 1964, Harlan J. Ptaszenski, Survey Chief MSHD (LCRC L1 P40) "Found Spring Leaf Buried 9" Near Center of Road
Intersection"
19" Maple S40°W 31.59' 9" Maple N40°W 67.18' 16" Oak N30°E 77.95'

February 9, 1976, Douglas W. Hooth, RLS #7966 MSHD (LCRC L1 P224) "Found Iron (Leaf Spring) (H.J. Page 1964 Leaf
Spring)"

28" Oak N30°E 77.72' 23" Maple S40°W 31.33' 11" Maple (In Cluster) N40°W 67.17'

B. Description of corner evidence found and/or method applied in restoring or reestablishing corner:

February 11, 1998 James J. Keller RLS #10693 (Field Book 138W Page 54) "Found Leaf Spring 8" Deep"

Set 60d SW side 12" Maple in clump N40°W 67.21'
Set 60d SE side 30" Oak N30°E 78.29'
Set PK Nail S side P.Pole N68°E 68.29'
Set 60d NW side 24" Maple S38°W 31.80'

APPROVED BY MECOSTA CO. PEER GROU
IN ACCORDANCE WITH P.A. 345 of 1990

CHAIRMAN

DATE

FEB. 13, 1998

C. Description of monument for corner and accessories established to perpetuate locating the position of the corner:

Accepted Leaf Spring & set Remonumentation Monument as a Careful and Faithful Perpetuation of the Position of the
Original Corner.


Found 60d & Set Tag SW side 12" Maple in clump N40°W 67.21'
Found 60d & Set Tag SE side 30" Oak N30°E 78.29'
Found PK Nail & Set Tag S side P.Pole N68°E 68.29'
Found 60d & Set Tag NW side 24" Maple S38°W 31.80'

Signed by

James J. Keller

Date June 1, 1998

Surveyor's Michigan License No. 10693

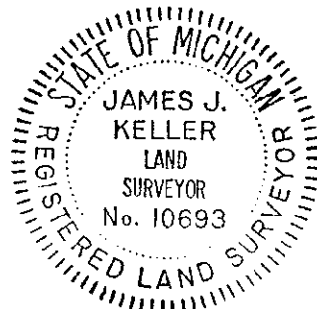

FORM APPROVED BY MICHIGAN STATE BOARD OF LAND SURVEYORS, JAN. 28, 1971
REVISED MAY 14, 1975
REVISED JAN., 1983
ADAPTED FOR WORD PROCESSING MARCH, 1983

SURVEY &
REMONUMENTATION


JUL 06 1998

SECTION

6-1-1998

JJK

LJH

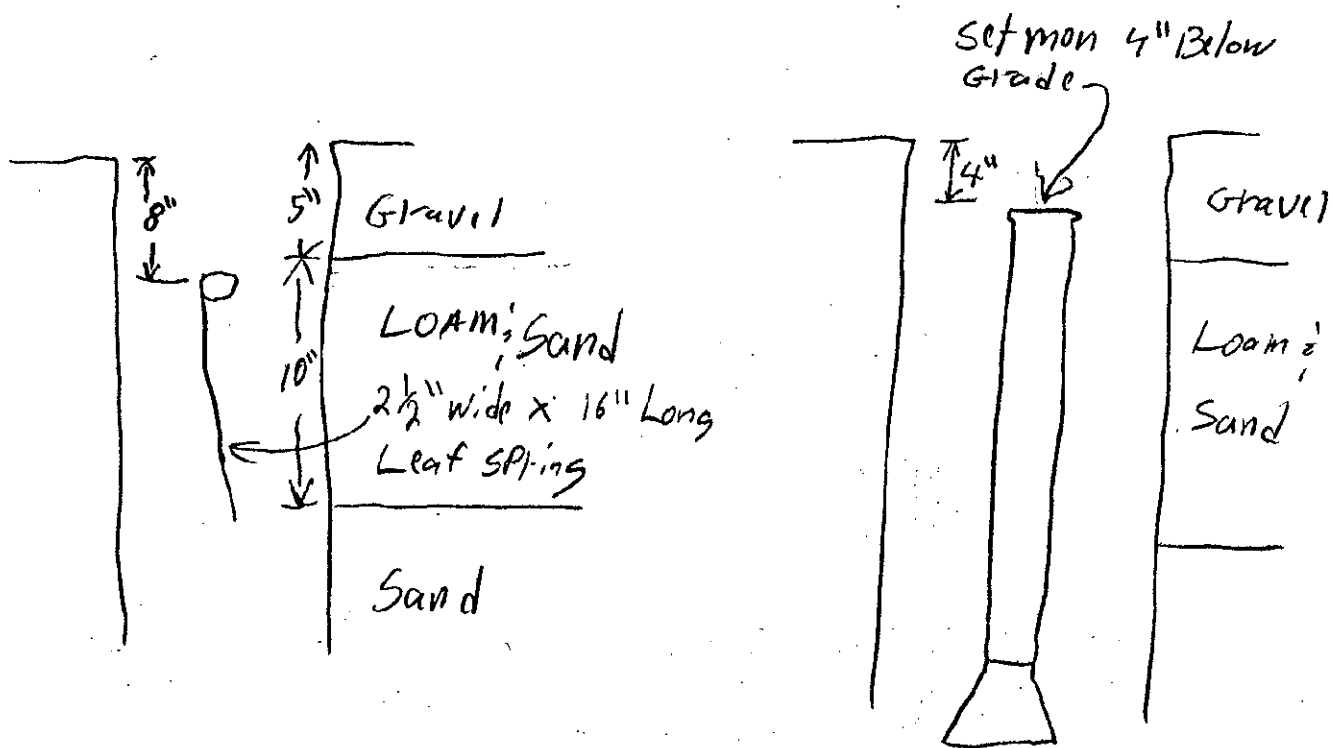

as Found

as Set