

APPROVED LAND CORNER
P.A. 345 OF 1990
MIDLAND COUNTY

REMON. COR. I-7, HOMER TWP.
LAND CORNER RECORDATION CERTIFICATE
Filing Requirement of Act 74, Mich. P.A. 1970

319

For corners in
Midland

(County)

Located in:

Corner Code #

1. Public Land Survey

T 14N R 1E

I-7

2. Property Controlling
in Section

S

T

R

3. Miscellaneous
Property in Sec.

S

T

R

4. Lot No. _____, Recorded Plat _____

5. Private Claims _____

STATE OF MICHIGAN
MIDLAND COUNTY
REMONUMENTATION & FILED

B DEC 97 11:03 A.M.

BEVERLY J THAYER
REGISTER OF DEEDS
Register of Deeds Stamp & File Number

I, RODNEY CLAYPOOL, in a field survey on JUNE 27, 1996, do hereby certify that under requirements of P.A. 74, Michigan P.A. of 1970, the corner points mentioned on lines 1 and 2 above were in conformance with regulations and rules therefore as required in the current manual of survey instructions of the United States Department of the Interior, Bureau of Land Management or by a decree of a Court of Law and/or that the corner points mentioned in lines 3, 4 and 5 above were in conformance with the rules of the Michigan Board of Land Surveyors or by a Decree of a Court of Law; re-established, monumented, re-monumented, recovered, found as expressed below:

NOTE: Not more than 2 corners, all in the same town and range, may be recorded on this certificate.


A. Description of original monument and accessories and/or subsequent restoration:

- I-7 Corner common to Sections 14, 15, 22, and 23
1831, government survey by H. Park, set corner
1910, survey of Sec 14 by Gibbs, no call
1915, survey of Sec 15 by Gibbs, corrugated steel rod 3/4" x 3"
1942, State Hwy witness card, found wood stake, placed axle shaft
1953, Survey by Hunter, no call
1955, survey by Hunter, no call
1957, survey by Hunter, mon box
1959, survey by Hunter, mon box
1964, survey by Whittier, mon box
1972, rec. survey by Schafer, L-1, P-90, mon box
1976, rec. survey by Whittier, L-2, P-22, iron in mon box
1977, rec. survey by Whittier, L-2, P-220
1978, rec. survey by Schafer, L-2, P-616, 1" rod in mon box
1979, Rec survey by Schafer, L-2, P-934, found mon box
1984, rec. survey by Jones, L-3, P-667, 1" rod in mon box
1986, rec. survey by Jones, L-3, P-919, 1/2" pipe in mon box
1987, survey by Jones, 1" rod in mon box
1988, rec. survey by Ledy, L-4, P-297, 3/4" pipe in mon box
1991, rec. survey by Ledy, L-4, P-787, 3/4" pipe in mon box
1995, rec. survey by Jones, L-5, P-316, bolt spike in mon box

SURVEY &
REMONUMENTATION

FEB 24 1998

SECTION

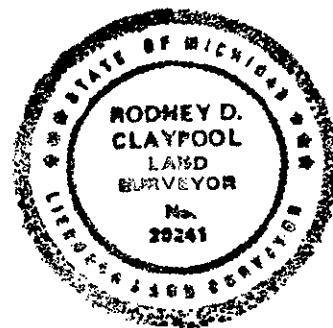

WITNESS NOTE: Witnesses from above surveys and LCRC's are available in dossier file; which was presented to peer review committee and is on file at the Register of Deeds Office.

B. Description of corner evidence found and/or method applied in restoring or reestablishing corner:

- I-7 Corner common to Sections 14, 15, 22 and 23
Found 3/4" pipe in mon box per surveys by F. Gibbs, MDOT, M. Hunter, D. Whittier, J. Schafer, J. Jones and D. Ledy.

Corner I-7 was approved for remonumentation at a Peer Review Committee Meeting on July 22, 1997.

C. Description of monument for corner and accessories established to perpetuate locating the position of the corner:

- I-7 Corner common to Sections 14, 15, 22 and 23
Found 3/4" pipe in mon box, replaced pipe with new 3/4" pipe and brass cap stamped Midland Co. Remon Cor. PS 29241, per surveys by F. Gibbs, MDOT, M. Hunter, D. Whittier, J. Jones and D. Ledy, and is accepted as the best available evidence of the position of the original corner.
N 35 Deg E, 90.40', pk nail in power pole S 35 Deg W, 67.69', nail in power pole
S 20 Deg E, 96.50', nail in telephone pole N 40 Deg W, 75.70', center line manhole

Signed by Rodney D. Claypool

Date 11-26-97

Surveyor's Michigan License No. 29241

Form approved by Michigan State Board of Land Surveyors, Jan. 28, 1971

Revised May 14, 1971

Revised Jan., 1983