

SURVEY & REMONUMENTATION

APPROVED LAND CORNER
P.A. 345 OF 1990
MIDLAND COUNTY

APR 28 1995

COMMISSION

LAND CORNER RECORDATION CERTIFICATE
Filing Requirement of Act 74, Mich. P.A. 1970

182

For corners in

MIDLAND
(County)

Located In:

Corner Code =#

1. Public Land Survey	T 15N R 1E	E-11
	T _____ R _____	_____
	T _____ R _____	_____
	T _____ R _____	_____
2. Property Controlling	S _____ T _____ R _____	_____
in Section	S _____ T _____ R _____	_____
3. Miscellaneous	S _____ T _____ R _____	_____
Property in Sec.	S _____ T _____ R _____	_____

STATE OF MICHIGAN
MIDLAND COUNTY
REMONUMENTATION & FILED

21 DEC 94 11:17 A.M.

BEVERLY J THAYER
REGISTER OF DEEDS

Register of Deeds Stamp & File Number

4. Lot No. _____, Recorded Plat _____
5. Private Claims _____

I, PAUL B. LAPHAM, in a field survey on NOVEMBER, 19 94, do hereby certify that under requirements of P.A. 74, Michigan P.A. of 1970, the corner points mentioned in lines 1 and 2 above were in conformance with regulations and rules therefore as required in the current manual of survey instructions of the United States Department of the Interior, Bureau of Land Management or by a decree of a Court of Law and/or that the corner points mentioned in lines 3, 4 and 5 above were in conformance with the rules of the Michigan Board of Land Surveyors or by a Decree of a Court of Law; established, re-established, monumented, re-monumented, recovered, found as expressed below:

NOTE: Not more than 4 corners, all in the same town and range, may be recorded on this certificate.

A. Description of original monument and accessories and/or subsequent restoration:

1831 HARVEY PARKE
INTERSECTED MER. 5.94' CHS. N. OF COR
WIT.-B. ASH 14" SOUTH 3 LKS.
BEECH 8" N23°E 50 LKS.

NO C.S.R.

3-27-68 M.S.H.D. R/W MAPS

8-3-77 JEROME SCHAFER, (132) SURVEY
WIT.-(1)S45°W M.S.H.D. TAG IN POWER POLE 102.16'
(2)N50°W N&T IN POWER POLE 87.72'

4-78 JEROME SCHAFER, (132) SURVEY
FOUND 3/4" PIPE IN MON. BOX
WIT.-(1)S65°W NAIL & M.S.H.D. DISC.
IN POWER POLE 102.16'
(2)N45°W N&T IN POWER POLE 87.73'

1987 LEDY, (132) SURVEY
FOUND 3/4" PIPE IN BOX
WIT.-(1)S45°W 102.61' TO M.S.H.D. TAG
IN POWER POLE
(2)N50°W 87.72' TO NAIL & ORANGE TAG

4-11-90 WILLIAM RUDDELL, L.C.R.C. I
FOUND PIPE IN MON. BOX
WIT.-(1) & (2) ABOVE
(3)N. NE 178.1' TO N&T
IN CUT OFF UTILITY POLE
(4)E 33.7' 1/2" I.D. PIPE

B. Description of corner evidence found and/or method applied in restoring or reestablishing corner:

FOUND 1"x18" PIPE IN MON. BOX 392.20' NORTH OF M-9, T15N, R1W (G.L.O. 392.04')
FOUND WITNESSES - 1, 2, 3, & 4.


Accepted as best available evidence of the position of the original corner & replaced with Standard Monument.

Corner, E-11 was approved for remonumentation at a Peer Review Committee Meeting on 12-05, 1994.

C. Description of monument for corner and accessories established to perpetuate locating the position of the corner:

E-11: 1/4 Corner common to Sections 28 & 33
Set 5/8" x 18" re-rod with brass cap stamped "Midland Co. Remon. Cor. PS 9433" in Monument Box.

WITNESSES:
S45°W 102.16' M.S.H.D. - TAG IN POWER POLE (1)
N45°W 87.72' - N&T IN POWER POLE (2)
N30°E 178.1' - N&T IN CUT-OFF UTILITY POLE (3)
EAST 33.7' 1/2" I.D. PIPE (4)

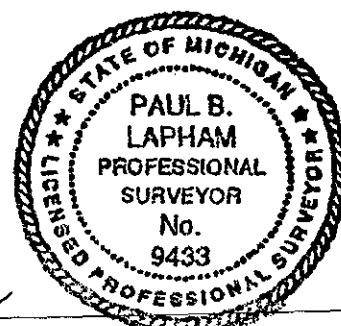

Signed by Paul B. Lapham

Date 12/19/94

Surveyor's Michigan License No. 9433