

Land Corner Recordation Certificate
Authority: 1970 PA 74, MCL 54.205


Surveyor's Name: Craig W. McVean
Field Survey Date: August 29, 2016
For corner(s) in: Midland County

Original Public Land Survey Corner
S T R
S T R
S T R
S T R

Property Controlling Corner
S T R
S T R
S T R
S T R

Property Corner
S 34 T 16N R 1W 5
S 34 T 16N R 1W 6
S T R
S T R

Protracted Public Land Survey Corner
S T R
S T R
S T R
S T R

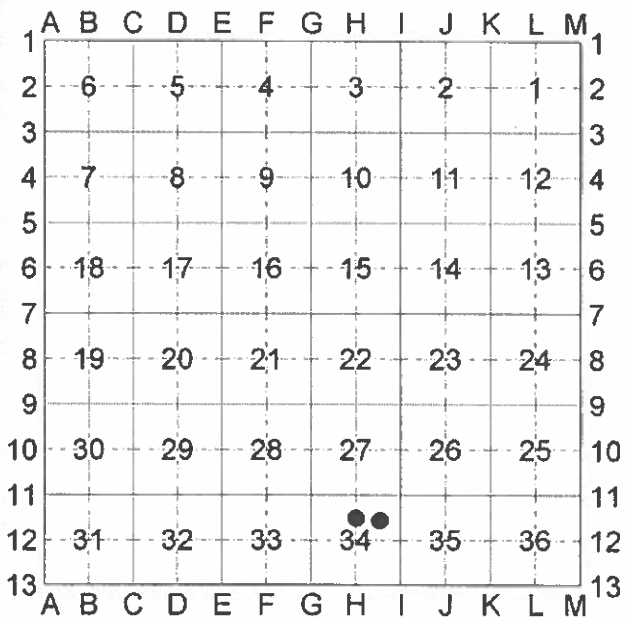

Part A: Corner History

- 5 – CN 1/16 corner Section 34, T16N, R1W. -No history
- 6 – NE 1/16 corner section 34, T16N, R1W. -No history

**Part B: Surveyor's Report on Perpetuation, Restoration, Reestablishment, or Monumentation of Corner**

5 – CN 1/16 corner Section 34, T16N, R1W-

Set stamped 2" Aluminum cap on 5/8" x 34" rebar per standard BLM procedure. Corner of wood post line north and east is S74°W 23'.

6 – NE 1/16 corner section 34, T16N, R1W-

Set stamped 2" Aluminum cap on 5/8" x 34" rebar per standard BLM procedure. Corner of wood post line west and south is 2.2' south.

**Part C: Field Evidence of Perpetuation or Monumentation of Corner**

5 – CN 1/16 corner Section 34, T16N, R1W-

Stamped 2" Aluminum cap on 5/8" x 34" long iron rebar.

Set blue composite post with location tag 1' southwest N17°W 18.99' to set nail & tag in west side 7" Red Maple  
S45°E 10.89' to set nail & tag in northeast side 5" Oak  
S06°W 24.67' to set nail & tag in east side 12" Oak  
N67°W 17.05' to set nail & tag in south side 5" Oak

6 – NE 1/16 corner section 34, T16N, R1W-

Stamped 2" Aluminum cap on 5/8" x 34" long iron rebar.

Set blue composite post with location tag 1' southwest N15°E 38.34' to set nail & tag in west side 11" Red Maple  
S13°W 22.91' to set nail & tag in east side 8" Red Maple  
S61°W 20.02' to set nail & tag in northwest side 11" Red Maple  
N54°W 23.43' to set nail & tag in northeast side 8" Red Maple



*Craig W. McVean*

Craig W. McVean

*9/5/2017*

Date

Professional Surveyor's License No.: 39088

Prepared By:  
Craig W. McVean  
Michigan Dept. of Natural Resources  
8015 Mackinaw Trail  
Cadillac, Michigan 49601

Land Corner Recordation Certificate  
S 34 T16N R1W Code 5  
S 34 T16N R1W Code 6