

APPROVED LAND CORNER
P.A. 345 OF 1990
MIDLAND COUNTY

REMON. COR. K-12, MILLS TWP.
LAND CORNER RECORDATION CERTIFICATE
Filing Requirement of Act 74, Mich. P.A. 1970

333

8/08/97 JJP
For corners in
Midland

(County)

Located in:

Corner Code #

1. Public Land Survey

T 16N R 2E

K-12

T R

T R

T R

T R

2. Property Controlling
in Section

S

T R

S

T R

3. Miscellaneous
Property in Sec.

S

T R

S

T R

4. Lot No. , Recorded Plat

5. Private Claims

STATE OF MICHIGAN
MIDLAND COUNTY
REMONUMENTATION & FILED

8 DEC 97 11:06 A.M.

BEVERLY J THAYER
REGISTER OF DEEDS

Register of Deeds Stamp & File Number

I, RODNEY CLAYPOOL, in a field survey on Feb 12, 1996, do hereby certify that under requirements of P.A. 74, Michigan P.A. of 1970, the corner points mentioned on lines 1 and 2 above were in conformance with regulations and rules therefore as required in the current manual of survey instructions of the United States Department of the Interior, Bureau of Land Management or by a decree of a Court of Law and/or that the corner points mentioned in lines 3, 4 and 5 above were in conformance with the rules of the Michigan Board of Land Surveyors or by a Decree of a Court of Law; re-established, monumented, re-monumented, recovered, found as expressed below:

NOTE: Not more than 2 corners, all in the same town and range, may be recorded on this certificate.

	A	B	C	D	E	F	G	H	I	J	K	L	M
2	6	5	4	3	2	1							
3													
4	7	8	9	10	11	12							
5													
6	18	17	16	15	14	13							
7													
8	19	20	21	22	23	24							
9													
10	30	29	28	27	26	25							
11													
12	31	32	33	34	35	36							
13													

A. Description of original monument and accessories and/or subsequent restoration:


K-12 Corner common to Sections 35 and 36

1831, Government Survey by R. Clark, set corner
1978, LCRC #471 and rec survey by Lansky, L-2, P-720
found spike in pavement 2" deep on line between
K-11 and K-13 at occupation line
1978, rec survey by Lansky, L-2, P-769 no call
1981, rec survey by Jones, L-3, P-216, nail in pavement,
same witness as Lansky
1984, rec survey by Ledy L-3, P-633, found spike in pavement, same witnesses
1987, rec survey by Ledy, L-4, P-177, found 3/4" pipe

SURVEY &
REMONUMENTATION

FEB 24 1998

SECTION

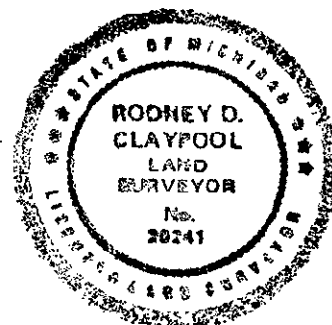

WITNESS NOTE: Witnesses from above surveys and LCRC's are available in dossier file; which was presented to peer review committee and is on file at the Register of Deeds Office.

B. Description of corner evidence found and/or method applied in restoring or reestablishing corner:

K-12 Corner common to Sections 35 and 36

Found railroad spike over 3/4" pipe per surveys by J. Lansky, J. Jones, D. Ledy and LCRC by J. Lansky

Corner K-12 was approved for remonumentation at a Peer Review Committee Meeting on August 8, 1997.

C. Description of monument for corner and accessories established to perpetuate locating the position of the corner:

K-12 Corner common to Sections 35 and 36

Found railroad spike over 3/4" pipe, replaced with 3/4" pipe and brass cap stamped Midland Co. Remon Cor. PS 29241 in mon box, per surveys by J. Lansky, J. Jones, D. Ledy and LCRC by J. Lansky; and is accepted to be the best available evidence of the position of the accepted corner.

N 45 Deg W, 34.56', nail in twin 10" Oak

N 80 Deg W, 27.37', nail in 10" Oak (R)

S 25 Deg W, 49.74', nail in twin 10" Oak (R)

S 88 Deg E, 49.40', nail and plastic disc in triple 8" Ash

East 8.4', center line road (R)

Signed by Rodney D. Claypool

Date 11-26-97

Surveyor's Michigan License No. 29241

Form approved by Michigan State Board of Land Surveyors, Jan. 28, 1971

Revised May 14, 1971

Revised Jan., 1983