

SURVEY &
REMONUMENTATION

APR 28 1995

COMMISSION

LAND CORNER RECORDATION CERTIFICATE
Filing Requirement of Act 74, Mich. P.A. 1970

RECEIVED FOR RECORD

94 DEC 29 AM 10:59

Peri Allen
REGISTER OF DEEDS
MONROE COUNTY, MICH

Register of Deeds Stamp & File Number

RATIFIED BY PEER GROUP
PA 345 OF 1990
MONROE COUNTY, MICHIGAN
date: 10/25/1994
County Rep.: [Signature]
For corners in

MONROE
(County)

Located In: ASH TWP.
Corner Code # M-7

1. Public Land Survey	T 5 S R 9 E	
	T R	
	T R	
	T R	
2. Property Controlling in Section	S T R	
	S T R	
3. Miscellaneous Property in Sec.	S T R	
	S T R	

4. Lot No. , Recorded Plat
5. Private Claims

1994 MONROE COUNTY REMONUMENTATION PROGRAM

Peer Group approved corner on 10/25/1994 per Act 345 of 1990.

I, G.B. WARNKE, JR., in a field survey on 11/14/1994, 19
do hereby certify that under requirements of P.A. 74, Michigan P.A. of 1970, the corner points mentioned in lines 1 and 2 above were in conformance with regulations and rules therefore as required in the current manual of survey instructions of the United States Department of the Interior, Bureau of Land Management or by a decree of a Court of Law and/or that the corner points mentioned in lines 3, 4 and 5 above were in conformance with the rules of the Michigan Board of Land Surveyors or by a Decree of a Court of Law; established, re-established, monumented, re-monumented, recovered, found as expressed below:

NOTE: Not more than 4 corners, all in the same town and range, may be recorded on this certificate.

A. Description of original monument and accessories and/or subsequent restoration:

M-7, T5S, R9E, Ash Township, Monroe County - ID No. 58 (not common to A-7, T5S, R10E)
Section Corner Common to Sections 13 and 24 on township line (Ready and Berlin Roads - soft surface)
1817, G.L.O. Surveyor, Joseph Wampler, notes: Beech 12 (inch) stands for corner of sect. 13 & 24. Notes of L.A. Howard, 1903 County Surveyor, indicates a found stone in April 1903. M.C.R.C. plans for Ready Road, Sheet 4, indicate a corner stone on Township line and being 149.2 feet south of stone at southwest corner of Section 18, Berlin Township at Station 210 + 18.0. 1991, G.B. Warnke set 1 inch x 33 inch iron pipe and recorded L.C.R.C., Liber 3, Page 229.

B. Description of corner evidence found and/or method applied in restoring or reestablishing corner:


M-7 - 9/5/1991, using L.A. Howard notes of 1903, turned his record angle occupying stone at south 1/4 corner and sighting stone at southwest corner (Angle left = 180°09'); prorated his chainage distance between found stones and used same proration for his chainage distance to the Township line and set 1 inch x 33 inch iron pipe in place with small field stones placed around it and witnessed as shown below.
11/14/1994, set 1 inch x 36 inch iron pipe with brass remonumentation cap in place of found 1 inch x 33 inch iron pipe.

C. Description of monument for corner and accessories established to perpetuate locating the position of the corner:

M-7 - Set 1 inch x 36 inch iron pipe with brass remonumentation cap in place of found 1 inch x 33 inch iron pipe and is accepted as the best available evidence of the position of the original corner and
Witnesses:
South 85° West 3.07 feet to east face of 6 inch diameter steel well casing
North 70° West 13.69 feet to southeast corner of frame shed
North 20° West 48.92 feet to southeast corner of residence No. 3980
North 75° East 30.77 feet to found nail/washer in south side utility pole
North 149.2 feet to southwest corner of Section 18, T5S, R10E
South 10° East +/- 1.8 feet to center of stone, which has been used as corner

Signed by [Signature]
Surveyor's Michigan License No. 19474

Date 11/14/1994

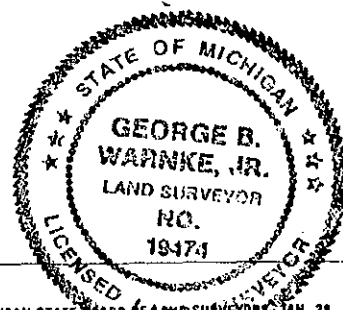

FORM APPROVED BY MICHIGAN STATE BOARD OF LAND SURVEYORS JAN. 28, 1971
REVISED MAY 14, 1975
REVISED JAN. 1983