

APR 05 1996

COMMISSION

LAND CORNER RECORDATION CERTIFICATE  
Filing Requirement of Act 74, Mich. P.A. 1970

For corners in

WAYNE

(County)

Located in: Brownstown  
Township

Corner Code #

1. Public Land Survey

T \_\_\_\_\_ R \_\_\_\_\_  
T \_\_\_\_\_ R \_\_\_\_\_  
T \_\_\_\_\_ R \_\_\_\_\_  
T \_\_\_\_\_ R \_\_\_\_\_

2. Property Controlling  
in Section

S 14&23 T 5S R 10E #001  
S \_\_\_\_\_ T \_\_\_\_\_ R \_\_\_\_\_

3. Miscellaneous  
Property in Sec.

S \_\_\_\_\_ T \_\_\_\_\_ R \_\_\_\_\_  
S \_\_\_\_\_ T \_\_\_\_\_ R \_\_\_\_\_

4. Lot No. \_\_\_\_\_, Recorded Plat \_\_\_\_\_

5. Private Claims \_\_\_\_\_

I, Randy Kolehhouse, in a field survey on October 12 19 94,  
do hereby certify that under requirements of P.A. 74 Michigan P.A. of 1970, the corner points  
mentioned in lines 1 and 2 above were in conformance with regulations and rules therefore as required  
in the current manual of survey instructions of the United States Department of the interior, Bureau of  
Land Management or by a decree of a Court of Law and/or that the corner points mentioned in lines 3,  
4 and 5 above were in conformance with the rules of the Michigan Board of Land Surveyors or by a  
Decree of a Court of Law; established, re-established, monumented, re-monumented, recovered,  
found as expressed below:

NOTE: Not more than 4 corners, all in the same town and range, may be recorded  
on this certificate.

A. Description of original monument and accessories and/or subsequent restoration:

1817	G.L.O. Notes	N/A	Post
1930's	WPA Survey Sec. Maps	N/A	N/A
1973	WCRC Notes	N/A	Monument in A.C. No. Box

B. Description of corner evidence found and/or method applied in restoring or reestablishing corner:

I found a concrete monument in a hole in the asphalt pavement at the C/L of Lee Road. This point is on the West line of P.C. #636  
and the South line of Sec. 14 (also the North line of Sec. 23). This point agrees with witnesses from an unrecorded survey done by  
Boyde Arthurs #11358, October 25, 1979 (provided by local resident). Witnessed NW corner Sec. 24 to a point 33' ± East of this  
point.

Nail w/Tag "WCRC" SW Side M.B.T. Pole NW 56.90'

Nail w/Tag "WCRC" E Side Util. Pole SW 58.43'

This point falls 20.93' (G.L.O. has 22' ±) West of an old fence row running N-S if extended South to C/L of road.

Measures North to K-6 = 2634.34' (WPA = 2634.78')

C. Description of monument for corner and accessories established to perpetuate locating the position of the corner:

Set aluminum cap "Wayne Co. Remon." on existing concrete monument.

IN NEW  
MONUMENT BOX

Nail w/Tag "WCRC" SE Face Util. Pole N 57° E 49.43'

P.K. w/Tag "RLS #19837" E Face Util. Pole S 30° W 58.27'

Nail w/Tag "WCRC" SW Face Util. Pole N 53° W 56.91'

Nail w/Tag "WCR" NE Face Util. Pole S 73° E 160.10'

The selected location is accepted by the Contractor and is generally accepted by professional surveyors as the best available  
evidence of the position of the original corner.

Signed by Randy J. Kolehhouse

Date

12/2/95

Surveyor's Michigan License No. 25854

\$ 4.00 REMONUMENTATION

\$ 7.00 DEED

8 DEC 95 12:40 P.M. RECEIPT

RECORDED

FOREST E. YOUNGBLOOD, REGISTER

EDS


WAYNE COUNTY, MI

LIBER 28451 PAGE 510

Compliance with  
ACT 345, P.A. 1990

APPROVED ON: 11-28-95  
WAYNE COUNTY REMONUMENTATION  
PEER GROUP COMMITTEE

Register of Deeds Stamp & File Number

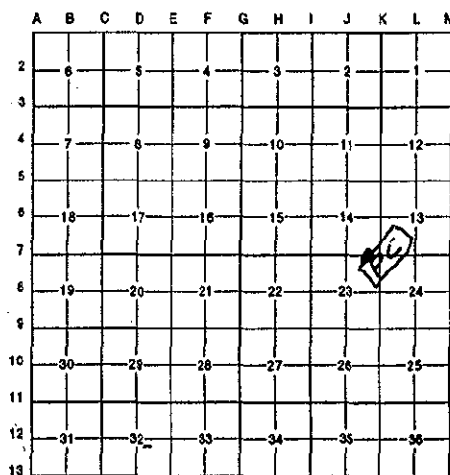

45262465

