

SURVEY &
REMONUMENTATION

APR 28 1995

COMMISSION

RECEIVED FOR RECORD

94 DEC 29 AM 11:06

RATIFIED BY PEER GROUP
PA 345 OF 1990
MONROE COUNTY, MICHIGAN

date: 10/26/1993

County Rep.: [Signature]

LAND CORNER RECORDATION CERTIFICATE
Filing Requirement of Act 74, Mich. P.A. 1970

For corners in

MONROE

(County)

Located In:

BEDFORD TWP.

Corner Code ##

- | | | |
|-------------------------|-------------|-----|
| 1. Public Land Survey | T 8 S R 7 E | E-3 |
| | T R | |
| | T R | |
| | T R | |
| | T R | |
| 2. Property Controlling | S T R | |
| in Section | S T R | |
| 3. Miscellaneous | S T R | |
| Property in Sec. | S T R | |

[Signature]
REGISTER OF DEEDS
MONROE COUNTY, MICH

Register of Deeds Stamp & File Number

4. Lot No. _____, Recorded Plat _____
5. Private Claims _____

MONROE COUNTY REMONUMENTATION PROGRAM Peer Group
approved corner on 10-26-1993 per Act 345 of 1990.

I, G.B. WARNKE, JR., in a field survey on 12/19, 1994,
do hereby certify that under requirements of P.A. 74, Michigan P.A. of 1970, the corner points mentioned
in lines 1 and 2 above were in conformance with regulations and rules therefore as required in the
current manual of survey instructions of the United States Department of the Interior, Bureau of Land
Management or by a decree of a Court of Law and/or that the corner points mentioned in lines 3, 4 and 5
above were in conformance with the rules of the Michigan Board of Land Surveyors or by a Decree of a
Court of Law; established, re-established, monumented, re-monumented, recovered, found as
expressed below:


NOTE: Not more than 4 corners, all in the same town and range, may be recorded
on this certificate.

A. Description of original monument and accessories and/or subsequent restoration:

E-3, T8S, R7E, Corner Common To Sections 4, 5, 8 & 9 (At Douglas Road & C.R. M-151)
G.L.O. Surveyor Joseph Wampler set post at Sections 4, 5, 8 & 9. Witnesses: B. Oak
18 inch N.2°W. 31 links & B. Oak 20 inch N.45°E. 47 links. / Old book indicates stone,
L.A. Howard(?) about 1903. / M.R. Fleck in November of 1950 states tile monument. / L.J.
Czubak, S-12581 Road survey found 3/4 inch bolt in March of 1964. After repaving, M.S.H.D.
Survey Chief K.M. Linbakka set a boat spike in monument box and rewitnessed 10/11/65. /
M.R. Fleck states iron pin in monument box in October of 1972. / L.E. Moree, January of
1975 recorded L.C.R.C., Liber 1, Page 476-477. / G.B. Warnke, December of 1989 recorded
L.C.R.C., Liber 3, Page 83. / Surveys from 1972 to date use iron pin in monument box set.

Description of corner evidence found and/or method applied in restoring or reestablishing corner:

E-3 - 10/22/1993, found 1 inch square head bolt in monument box set in concrete pavement
and witnessed as shown below. 12/19/1994, set plastic remonumentation cap on existing
square head bolt in monument box.

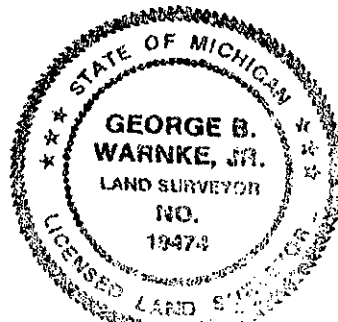

Description of monument for corner and accessories established to perpetuate locating the position of the corner:

E-3 - Found 1 Inch Square Head Bolt In Monument Box In Concrete Pavement and is accepted
as the best available evidence of the position of the original corner and witnesses:
North 50° West 38.80' nail/shiner in south face of telephone pole
North 45° East 60.58' nail/shiner in south face of telephone pole (2 1/2 feet above ground)
South 45° West 55.77' P.K. nail/shiner in northeast face of utility pole
South 45° East 73.65' nail/shiner in north face of telephone pole
North 45° West 67.01' nail/shiner in southeast face of utility pole (+/- 5 feet above ground)
South 60° East 115.28' northwest corner of frame building

12/19/1994, set plastic cap on existing square head bolt in monument box.

Red by [Signature] Date 12/19/1994

Surveyor's Michigan License No. 19474