

SURVEY &  
REMONUMENTATION

LIBER 1810 PAGE 24

APR 28 1995

COMMISSION

LAND CORNER RECORDATION CERTIFICATE  
Filing Requirement of Act 74, Mich. P.A. 1970

For corners in

MUSKEGON  
(County)

Located In:

Corner Code ##

1. Public Land Survey

T 9 R 15

J-10

T R

T R

T R

2. Property Controlling  
in Section

S 26 T 9 R 15

S T R

3. Miscellaneous  
Property in Sec.

S T R

S T R

4. Lot No. , Recorded Plat

5. Private Claims

Register of Deeds Stamp & File Number

STATE OF MICHIGAN  
COUNTY OF MUSKEGON  
REGISTER OF DEEDS  
1994 DEC 27 AM 11:41  
Debbie Carter

A1531

I, STEPHEN V. VALLIER in a field survey on DECEMBER, 19 94, do hereby certify that under requirements of P.A. 74, Michigan P.A. of 1970, the corner points mentioned in lines 1 and 2 above were in conformance with regulations and rules therefore as required in the current manual of survey instructions of the United States Department of the Interior, Bureau of Land Management or by a decree of a Court of Law and/or that the corner points mentioned in lines 3, 4 and 5 above were in conformance with the rules of the Michigan Board of Land Surveyors or by a Decree of a Court of Law; established, re-established, monumented, re-monumented, recovered, found as expressed below:

**NOTE:** Not more than 4 corners, all in the same town and range, may be recorded on this certificate.

A. Description of original monument and accessories and/or subsequent restoration:

1964 C.F. LEWANDOWSKI FOUND IRON AT FENCE INTERSECTION AT THE E-W 1/4 LINE

CORNER NOT SET BY GLO

B. Description of corner evidence found and/or method applied in restoring or reestablishing corner:

FOUND 3/4" x 2.8' IRON PIPE AT FENCE CORNER TO WEST AND NORTH. IRON ON E-W 1/4 LINE- APPROXIMATELY 19' EAST OF COMPUTED INTERSECTION BY 1/4 LINES. FOUND HISTORICAL USAGE & ACCEPTANCE TO THIS CORNER. FOUND 1" IRON PIPE N35 W 6.93'


June 7 1994 SC  
POSITION OF SAID  
RECORDED CORNER  
REVIEWED & RATIFIED  
BY MUSKEGON COUNTY  
PEER GROUP IN ACCORDANCE  
WITH P.A. 345, OF 1990

C. Description of monument for corner and accessories established to perpetuate locating the position of the corner:

REPLACED 3/4" x 2.8' IRON PIPE WITH CAST IRON MONUMENT WITH COUNTY SURVEYOR CAP  
2 3/4" x 30"  
S86° W 15.72' 18" RED PINE (SET NAIL SOUTH SIDE)  
S3° E 20.40' 16" RED PINE (SET NAIL WEST SIDE)  
N50° E 27.79' 16" TWIN OAK (SET NAIL SOUTH SIDE)  
N37° E 16.50' 14" OAK (SET NAIL WEST SIDE)  
S73° E 38.53' 8" OAK (SET NAIL SOUTH SIDE)

Signed by

Surveyor's Michigan License No.

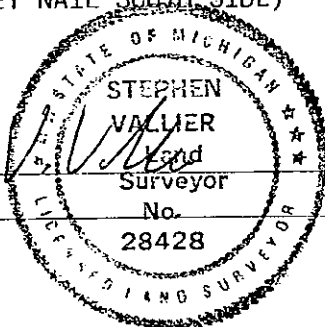

Date

Dec 24, 1994