

SURVEY &
REMONUMENTATION

LIBER 1810 PAGE 543

APR 28 1995

LAND CORNER RECORDATION CERTIFICATE
Filing Requirement of Act 74, Mich. P.A. 1970

For corners in
MUSKEGON

COMMISSION

(County)

Located In:

Corner Code #

1. Public Land Survey T 9N R 15W L-11
T R
T R
T R
T R
2. Property Controlling S T R
in Section S T R
3. Miscellaneous S T R
Property in Sec. S T R

4. Lot No. , Recorded Plat
5. Private Claims

STEPHEN V. VALLIER, in a field survey on NOVEMBER, 19 94, do hereby certify that under requirements of P.A. 74, Michigan P.A. of 1970, the corner points mentioned in lines 1 and 2 above were in conformance with regulations and rules therefore as required in the current manual of survey instructions of the United States Department of the Interior, Bureau of Land Management or by a decree of a Court of Law and/or that the corner points mentioned in lines 3, 4 and 5 above were in conformance with the rules of the Michigan Board of Land Surveyors or by a Decree of a Court of Law; established, re-established, monumented, re-monumented, recovered, found as expressed below:

NOTE: Not more than 4 corners, all in the same town and range, may be recorded on this certificate.

A. Description of original monument and accessories and/or subsequent restoration:

1837 GLO SET 1/4 CORNER

1977 F.F. SMITH, SET 1/2" IRON ROD AS LOST CORNER, MIDWAY ON LINE

1982 C.F. LEWANDOWSKI, LBR. 1242, PG. 319, FOUND 1/2" IRON ROD- RESET WITH 4" X 30" CAST IRON MONUMENT WITH COUNTY SURVEY CAP

B. Description of corner evidence found and/or method applied in restoring or reestablishing corner:

FOUND 4" CAST IRON MONUMENT WITH COUNTY SURVEY CAP
ACCEPTED POSITION OF EXISTING CORNER AND METHOD OF RESTORATION


POSITION OF SAID
RECORDED CORNER
REVIEWED & RATIFIED
BY MUSKEGON COUNTY
PEER GROUP IN ACCORDANCE
WITH P.A. 345, OF 1990

OCT 4, 1994

C. Description of monument for corner and accessories established to perpetuate locating the position of the corner:

4" CAST IRON MONUMENT WITH COUNTY SURVEY CAP

N 15° W 32.55' P. POLE WITH NAIL
S 50° W 53.25' 28" MAPLE WITH NAIL
S 12° W 41.39' 36" MAPLE WITH NAIL
S 70° E 52.59' MAPLE CLUMP WITH NAIL

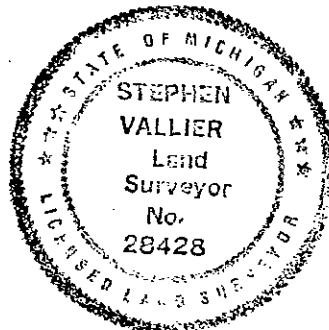

Signed by

Date

Surveyor's Michigan License 28428