

SAME AS A-2 ✓
TION, R16W

LAND CORNER RECORDATION CERTIFICATE
Filing Requirement of Act 74, Mich. P.A. 1970

LIBEP 27 PW 1:10

For corners in
Muskegon
(County)

Located In:
s/b SECTION pm

Corner Code #

1. Public Land Survey

T 41N R 17W

M-2

2. Property Controlling
in Section

S T R

3. Miscellaneous
Property in Sec.

S T R

Register of Deeds Stamp & File Number

NOV 28 2000

4. Lot No. Recorded Plat

5. Private Claims

SECTION

I, Stephen V. Vallier, P.S., in a field survey on November 96, 19, do hereby certify that under requirements of P.A. 74, Michigan P.A. of 1970, the corner points mentioned in lines 1 and 2 above were in conformance with regulations and rules therefore as required in the current manual of survey instructions of the United States Department of the Interior, Bureau of Land Management or by a decree of a Court of Law and/or that the corner points mentioned in lines 3, 4 and 5 above were in conformance with the rules of the Michigan Board of Land Surveyors or by a Decree of a Court of Law; established, re-established, monumented, re-monumented, recovered, found as expressed below:

	A	B	C	D	E	F	G	H	I	J	K	L	M
2	6	5	4	3	2	1							
3													
4	7	8	9	10	11	12							
5													
6	18	17	16	15	14	13							
7													
8	19	20	21	22	23	24							
9													
10	30	29	28	27	26	25							
11													
12	31	32	33	34	35	36							
13													

NOTE: Not more than 4 corners, all in the same town and range, may be recorded on this certificate.

A. Description of original monument and accessories and/or subsequent restoration:

1837 G.L.O. SET CORNER

SOUTH 18° WEST 45 LINKS
NORTH 12° WEST 83 LINKS

10" PINE
20" BLACK OAK

1925 M.C.R.C. 1" IRON BAR

SOUTHEAST 42.85'
NORTHEAST 100.95
NORTHWEST 125.75

20" RED OAK
TELEPHONE POLE
12" RED OAK

*SEE ATTACHED EXHIBIT "M-2"

B. Description of corner evidence found and/or method applied in restoring or reestablishing corner:

FOUND 3 X 23" TORSION BAR AND 1' FLAT STOCK.

NORTH 07° WEST 125.84' 40' OAK SET SPIKE
SOUTH " 2660.20' TO SOUTHEAST CORNER OF SECTION

DOCUMENTATION, MEASUREMENTS AND HISTORICAL USAGE HAS BEEN CONSISTENT SINCE 1920's.

ACCEPTED POSITION OF CORNER.

POSITION OF SAID 8/13/96
RECORDED CORNER
REVIEWED & RATIFIED
BY MUSKEGON COUNTY
PEER GROUP IN ACCORDANCE
WITH P.A. 345, OF 1990


C. Description of monument for corner and accessories established to perpetuate localizing the position of the corner:

REPLACED 3" X 23" TORSION BAR AND 1" FLAT STOCK WITH 2 3/4" X 3'- CAST IRON MONUMENT WITH COUNTY SURVEY CAP.

NORTH 81° WEST 31.24' TELEPHONE POLE
SOUTH 15° EAST 86.98' POWER POLE
SOUTH 43° EAST 67.63" 14" PINE
NORTH 24° EAST 98.98" POWER POLE
NORTH 43° EAST 96.86" 14" PINE
NORTH 07° WEST 125.84' 40' OAK

FOUND SPIKE ON NORTH SIDE
FOUND SPIKE ON WEST SIDE
FOUND SPIKE ON WEST SIDE
FOUND SPIKE ON WEST SIDE
FOUND SPIKE ON WEST SIDE
SET SPIKE ON EAST SIDE

Signed by
Surveyor's Michigan License No. 28428

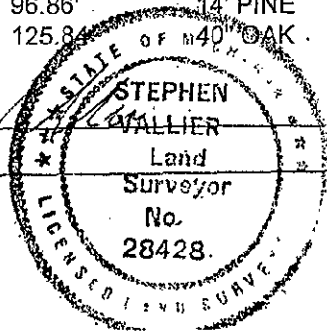

Date Dec 23 1996