

SURVEY & REMONUMENTATION

MAR 21 1997

1952 PAGE 828

COMMISSION

LAND CORNER RECORDATION CERTIFICATE
Filing Requirement of Act 74, Mich. P.A. 1970

For corners in
Muskegon

(County)

Located In:

Corner Code ##

1. Public Land Survey

T10N R17W

K-3

2. Property Controlling
in Section

S T R

3. Miscellaneous
Property in Sec.

S T R

4. Lot No. , Recorded Plat

5. Private Claims

I, S. Shackelford, P.S., in a field survey on October 30, 1996, do hereby certify that under requirements of P.A. 74, Michigan P.A. of 1970, the corner points mentioned in lines 1 and 2 above were in conformance with regulations and rules therefore as required in the current manual of survey instructions of the United States Department of the Interior, Bureau of Land Management or by a decree of a Court of Law and/or that the corner points mentioned in lines 3, 4 and 5 above were in conformance with the rules of the Michigan Board of Land Surveyors or by a Decree of a Court of Law; established, re-established, monumented, re-monumented, recovered, found as expressed below:

NOTE: Not more than 4 corners, all in the same town and range, may be recorded on this certificate.

A. Description of original monument and accessories and/or subsequent restoration:

1837 G.L.O. SET CORNER
SOUTH 21° WEST 19 LINKS 24" PINE
NORTH 33° EAST 36 LINKS 22" PINE
1920's CORNER NOT DESCRIBED
SOUTHWEST 71.90 8" APPLE
SOUTHEAST 59.92 18" MAPLE
NORTHWEST 99.90 8" OAK

SEE ATTACHED EXHIBIT "K-3"

B. Description of corner evidence found and/or method applied in restoring or reestablishing corner:

FOUND 2 3/4 X 30" CAST IRON MONUMENT WITH COUNTY SURVEYOR LEGEND IN MONUMENT BOX

NORTH 58° WEST 59.32 POWER POLE
NORTH 44° EAST 70.48 POWER POLE
SOUTH 60° WEST 60.06 TELEPHONE POLE

CHECKS POSITION OF HISTORICAL USAGE
CHECKS PLAT OF ELM HILL

POSITION OF SAID
RECORDED CORNER
REVIEWED & RATIFIED
BY MUSKEGON COUNTY
PEER GROUP IN ACCORDANCE
WITH P.A. 345, OF 1990

C. Description of monument for corner and accessories established to perpetuate locating the position of the corner:


FOUND 2 3/4" X 30" CAST IRON MONUMENT WITH COUNTY SURVEYOR LEGEND IN MONUMENT BOX

NORTH 58° WEST 59.32 POWER POLE FOUND SPIKE
NORTH 44° EAST 70.48 POWER POLE FOUND SPIKE
SOUTH 60° WEST 60.06 TELEPHONE POLE FOUND SPIKE

Signed by Stanley H. Shackelford 30100

Date 12-26-96

Surveyor's Michigan License No. 30100

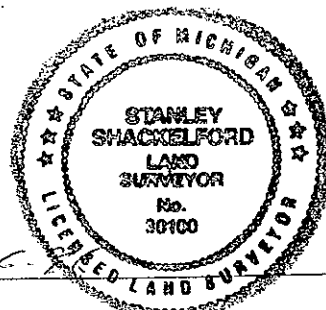

FORM APPROVED BY MICHIGAN STATE BOARD OF LAND SURVEYORS, JAN. 28, 1971
REVISED MAY 14, 1975
REVISED JAN., 1983

A1850

9.00

EXHIBIT K-3"

LIBER 1952 PAGE 829

1950's M.C.R.C. CORNER NOT DESCRIBED

NORTHWEST	99.90	15" WHITE OAK
NORTHEAST	59.42	POWER POLE
SOUTHWEST	79.10	18" OAK
SOUTHEAST	60.25	30" MAPLE
SOUTHEAST	90.00	18" MAPLE

1985 LIBER 1322, PAGE 622 BY C.F.L.

FOUND BOLT SPIKE IN MONUMENT BOX SET 2-3/4" X 30" CAST IRON MONUMENT WITH COUNTY SURVEYOR
LEGEND IN MONUMENT BOX

NORTH 58° WEST	59.32	POWER POLE
NORTH 44° EAST	70.48	POWER POLE
SOUTH 67° EAST	93.33	36" MAPLE
SOUTH 60° WEST	60.06	TELEPHONE POLE