

SURVEY & REMONUMENTATION

APR 28 1995

LIBER 1810 PAGE 623

STATE OF MICHIGAN
COUNTY OF MUSKEGON
RECEIVED FOR RECORD

1994 DEC 29 AM 10:18

COMMISSION

LAND CORNER RECORDATION CERTIFICATE
Filing Requirement of Act 74, Mich. P.A. 1970

For corners in

Muskegon
(County)

Located In:

Corner Code ##

- | | | |
|------------------------------------|-------------|-----|
| 1. Public Land Survey | T 11N R 16W | F 3 |
| | T R | |
| | T R | |
| | T R | |
| 2. Property Controlling in Section | S T R | |
| | S T R | |
| 3. Miscellaneous Property in Sec. | S T R | |
| | S T R | |

Register of Deeds Stamp & File Number

4. Lot No. _____, Recorded Plat _____
5. Private Claims _____

A1647

I, Ralph W. VanRiper, in a field survey on November 4, 1994, do hereby certify that under requirements of P.A. 74, Michigan P.A. of 1970, the corner points mentioned in lines 1 and 2 above were in conformance with regulations and rules therefore as required in the current manual of survey instructions of the United States Department of the Interior, Bureau of Land Management or by a decree of a Court of Law and/or that the corner points mentioned in lines 3, 4 and 5 above were in conformance with the rules of the Michigan Board of Land Surveyors or by a Decree of a Court of Law; established, re-established, monumented, re-monumented, recovered, found as expressed below:

NOTE: Not more than 4 corners, all in the same town and range, may be recorded on this certificate.

A. Description of original monument and accessories and/or subsequent restoration:

1/4 Corner between Sections 4 and 9, T 11 N, R 16 W,
Dalton Township

Set post June 24, 1837, by GLO Surveyors

Spruce 8" S 59° E 21 L
Spruce 8" N 46° W 17 L

B. Description of corner evidence found and/or method applied in restoring or reestablishing corner:

Found 1" pipe, recorded by Donald L. Bissell, RLS #18655,
Liber 1377, Page 433, January 28, 1987.

N 41° E 24.56' 8" Oak
S 25° E 35.95' 12" W. Oak
S 73° W 10.42' 8" W. Oak
N 27° W 13.58' 10" W. Oak


POSITION OF SAID
RECORDED CORNER
REVIEWED & RATIFIED
BY MUSKEGON COUNTY
PEER GROUP IN ACCORDANCE
WITH P.A. 345, OF 1980

May 2, 1994

C. Description of monument for corner and accessories established to perpetuate locating the position of the corner:

Set 4" by 20" monument with County Surveyor Cap.

S 60° W 10.55' Fd. nail South side 14" Oak
N 40° E 24.55' Fd. nail SE side 12" Oak
N 30° W 13.62' Fd. nail North side 14" Oak
S 83° E 22.68' Set nail South side 6" Pine
S 15° W 14.25' Set nail East side 6" Oak
S 20° E 35.97' Fd. DNR Tag East side 16" Oak

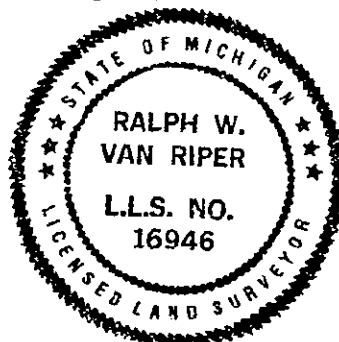

Signed by Ralph W. Van Riper
Surveyor's Michigan License No. 16946

Date 12/27/94