

SURVEY &
REMONUMENTATION

LIBER 1810 PAGE 576

STATE OF MICHIGAN
COUNTY OF MUSKEGON
RECEIVED FOR RECORD

APR 28 1995

LAND CORNER RECORDATION CERTIFICATE
Filing Requirement of Act 74, Mich. P.A. 1970

1994 DEC 29 AM 10:14

COMMISSION

For corners in

Muskegon
(County)

Located In:

Corner Code #

1. Public Land Survey T 11 R 16 G-9
T R
T R
T R
2. Property Controlling S T R
in Section S T R
3. Miscellaneous S T R
Property in Sec. S T R

Carrie Carter
REGISTER OF DEEDS

A1600

Register of Deeds Stamp & File Number

4. Lot No. , Recorded Plat
5. Private Claims

I, Stephen V. Vallier, in a field survey on December, 1994, do hereby certify that under requirements of P.A. 74, Michigan P.A. of 1970, the corner points mentioned in lines 1 and 2 above were in conformance with regulations and rules therefore as required in the current manual of survey instructions of the United States Department of the Interior, Bureau of Land Management or by a decree of a Court of Law and/or that the corner points mentioned in lines 3, 4 and 5 above were in conformance with the rules of the Michigan Board of Land Surveyors or by a Decree of a Court of Law; established, re-established, monumented, re-monumented, recovered, found as expressed below:

| | A | B | C | D | E | F | G | H | I | J | K | L | M |
|----|----|----|----|----|----|----|---|---|---|---|---|---|---|
| 2 | 6 | 5 | 4 | 3 | 2 | 1 | | | | | | | |
| 3 | | | | | | | | | | | | | |
| 4 | 7 | 8 | 9 | 10 | 11 | 12 | | | | | | | |
| 5 | | | | | | | | | | | | | |
| 6 | 16 | 17 | 18 | 15 | 14 | 13 | | | | | | | |
| 7 | | | | | | | | | | | | | |
| 8 | 19 | 20 | 21 | 22 | 23 | 24 | | | | | | | |
| 9 | | | | | | | | | | | | | |
| 10 | 30 | 29 | 28 | 27 | 26 | 25 | | | | | | | |
| 11 | | | | | | | | | | | | | |
| 12 | 31 | 32 | 33 | 34 | 35 | 36 | | | | | | | |
| 13 | | | | | | | | | | | | | |

NOTE: Not more than 4 corners, all in the same town and range, may be recorded on this certificate.

A. Description of original monument and accessories and/or subsequent restoration:

1837 GLO set corner
1950's M.C.R.C. Tie Map - witnesses only
1982 C.F. Lewandowski - L.C.R.C. Liber 1237 Page 418 Found 1" Iron
Reset with 4" x 30" Cast Iron Monument with County Survey Cap.

B. Description of corner evidence found and/or method applied in restoring or reestablishing corner:

Found 4" Cast Iron Monument with County Survey Cap.
Accepted position of corner due to evidence of Historical usage
and consistent documentation.


POSITION OF SAID
RECORDED CORNER
REVIEWED & RATIFIED
BY MUSKEGON COUNTY
PEER GROUP IN ACCORDANCE
WITH P.A. 345, OF 1990

May 4 1997

C. Description of monument for corner and accessories established to perpetuate locating the position of the corner:

4" Cast Iron monument with County Survey Cap.

S 20 deg E 56.66' Guy Pole with Nail
S 30 deg W 61.05' Power Pole with Nail
N 35 deg W 87.29' 14" Twin Maple with Nail

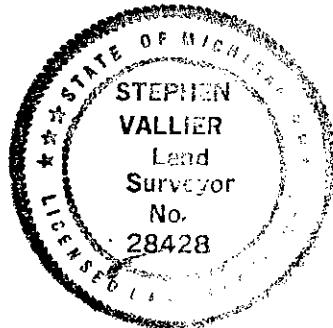

Signed by Stephen Vallier

Date Dec 27, 1994

Surveyor's Michigan License No. 28428