

SURVEY &
REMONUMENTATION

USE 1810 577

APR 28 1995

STATE OF MICHIGAN
COUNTY OF MUSKEGON
RECEIVED FOR RECORD

1994 DEC 29 AM 10:14

COMMISSION

LAND CORNER RECORDATION CERTIFICATE
Filing Requirement of Act 74, Mich. P.A. 1970

For corners in

Muskegon
(County)

Located In:

Corner Code ##

1. Public Land Survey T 11 R 16 6-10
T R
T R
T R
2. Property Controlling S T R
in Section S T R
3. Miscellaneous S T R
Property in Sec. S T R

4. Lot No. , Recorded Plat
5. Private Claims

Carrie Carter
REGISTER OF DEEDS

A1601

Register of Deeds Stamp & File Number

I, Stephen V. Vallier, field survey on December, 1994,
do hereby certify that under requirements of P.A. 74, Michigan P.A. of 1970, the corner points mentioned
in lines 1 and 2 above were in conformance with regulations and rules therefore as required in the
current manual of survey instructions of the United States Department of the Interior, Bureau of Land
Management or by a decree of a Court of Law and/or that the corner points mentioned in lines 3, 4 and 5
above were in conformance with the rules of the Michigan Board of Land Surveyors or by a Decree of a
Court of Law; established, re-established, monumented, re-monumented, recovered, found as
expressed below:


**NOTE: Not more than 4 corners, all in the same town and range, may be recorded
on this certificate.**

A. Description of original monument and accessories and/or subsequent restoration:

1837 GLO set corner
1950's M.C.R.C. Tie Map - 2" Iron Pipe and 1/2" Iron Bar
1982 C.F. Lewandowski - L.C.R.C. Liber 1237 Page 418 - Found 1 1/2"
pipe above large iron. Reset with 4" x 30" cast iron monument
with County Survey Cap.

B. Description of corner evidence found and/or method applied in restoring or reestablishing corner:


Found 4" Cast Iron Monument with County Survey Cap.
Accepted position of corner due to evidence of Historical usage
and consistent documentation.

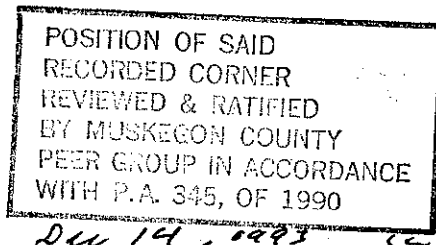

C. Description of monument for corner and accessories established to perpetuate locating the position of the corner:

4" Cast Iron Monument with County Survey Cap.

N 50 deg E 40.12' 11" White Oak with nail
E 33.00' Iron
S 83 deg E 23.10' Guy Pole with nail

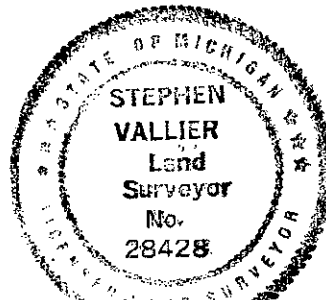

Signed by

Stephen Vallier

Date

Dec 27, 1994

Surveyor's Michigan License No.

28428