

1993

COMMISSION

LAND CORNER RECORDATION CERTIFICATE
Filing Requirement of Act 74, Mich. P.A. 1970

For corners in

Muskegon

(County)

Located In:

Corner Code ##

1. Public Land Survey

T 11N R 16W

G 13

T R

T R

T R

S T R

S T R

S T R

S T R

2. Property Controlling
in Section

3. Miscellaneous

Property in Sec.

4. Lot No. , Recorded Plat

5. Private Claims

Cassie Carter
REGISTER OF DEEDS

1993 DEC 29 PM 3:09

STATE OF MICHIGAN
COUNTY OF MUSKEGON
RECEIVED FOR RECORD

Register of Deeds Stamp & File Number

I, Ralph W. VanRiper, in a field survey on June 18, 1993,
do hereby certify that under requirements of P.A. 74, Michigan P.A. of 1970, the corner points mentioned
in lines 1 and 2 above were in conformance with regulations and rules therefore as required in the
current manual of survey instructions of the United States Department of the Interior, Bureau of Land
Management or by a decree of a Court of Law and/or that the corner points mentioned in lines 3, 4 and 5
above were in conformance with the rules of the Michigan Board of Land Surveyors or by a Decree of a
Court of Law; established, re-established, monumented, re-monumented, recovered, found as
expressed below:

NOTE: Not more than 4 corners, all in the same town and range, may be recorded
on this certificate.

A. Description of original monument and accessories and/or subsequent restoration:

Southwest corner of Section 34 or Southeast Corner of Section 33,
T 11 N, R 16 W, Dalton Township

Set Post in 1836 by GLO Surveyors

W Oak 12" N 61° E 47 L

W Oak 10" N 55° W 20 L

B. Description of corner evidence found and/or method applied in restoring or reestablishing corner:

Found Hex Iron inside of 3/4" Pipe, as per
Muskegon County Road Comm. Witness Book

NE P.P. 65.25'

NE 15" O. 59.78'

SE P.P. 80.9'

Historical usage, documentation and evidence
of corner location reviewed and ratified by
Muskegon County Peer Group, June 15, 1993

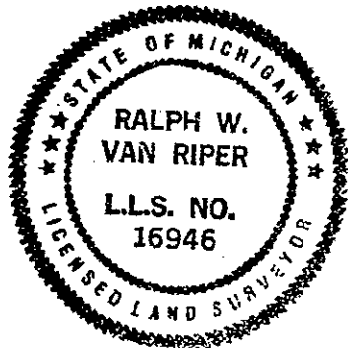
SSE 12" B.O. 55'

SW 18" B.O. 59.94'

C. Description of monument for corner and accessories established to perpetuate locating the position of the corner:

Set 2 3/4" by 20" Cast Iron Monument with County Survey Cap

N 43° E 64.95' Fd. Spike in Power Pole
N 47° E 42.85' Center Bolt of Fire Hydrant
S 68° E 88.21' Fd. Spike in Guy Pole
S 46° W 88.45' Fd. Spike in 20" Pine
N 38° W 69.50' Fd. Spike in Power Pole
N 34° W 60.55' Set Spike in 10" Pine

Signed by Ralph W. Van Riper

Date Dec. 28, 1993

Surveyor's Michigan License No. 16946