

SURVEY &
REMONUMENTATION

APR 28 1995

LIBER 1810 PAGE 641

STATE OF MICHIGAN
COUNTY OF MUSKEGON
RECEIVED FOR RECORD

1994 DEC 29 AM 10:19

COMMISSION

LAND CORNER RECORDATION CERTIFICATE
Filing Requirement of Act 74, Mich. P.A. 1970

Carrie Carter
REGISTER OF DEEDS

For corners in

Muskegon
(County)

Located in:

Corner Code ##

- | | | |
|------------------------------------|-------------|-----|
| 1. Public Land Survey | T 11N R 16W | J 1 |
| | T R | |
| | T R | |
| | T R | |
| 2. Property Controlling in Section | S T R | |
| | S T R | |
| 3. Miscellaneous | S T R | |
| Property in Sec. | S T R | |

Register of Deeds Stamp & File Number

4. Lot No. _____, Recorded Plat _____
5. Private Claims _____

I, Ralph W. VanRiper, in a field survey on June 30, 19 94, do hereby certify that under requirements of P.A. 74, Michigan P.A. of 1970, the corner points mentioned in lines 1 and 2 above were in conformance with regulations and rules therefore as required in the current manual of survey instructions of the United States Department of the Interior, Bureau of Land Management or by a decree of a Court of Law and/or that the corner points mentioned in lines 3, 4 and 5 above were in conformance with the rules of the Michigan Board of Land Surveyors or by a Decree of a Court of Law; established, re-established, monumented, re-monumented, recovered, found as expressed below:

NOTE: Not more than 4 corners, all in the same town and range, may be recorded on this certificate.

A. Description of original monument and accessories and/or subsequent restoration:


N 1/4 corner of Section 2, T 11 N, R 16 W,
Dalton Township.

Not set by GLO Surveyors

B. Description of corner evidence found and/or method applied in restoring or reestablishing corner:

Found RR spike as per Muskegon County Road Commission
Witness book, recorded by Stanley Shackelford, LLS #30100
Liber 1518, Page 01, May 9, 1990.

NE 70.30' 10" Oak
SW 50.60' 8" Oak
W 86.80' Iron rod

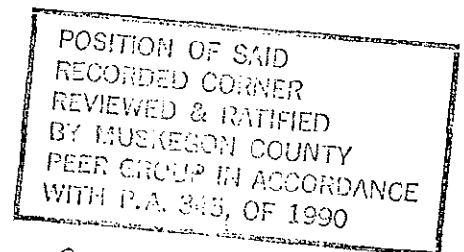


May 2, 1994

C. Description of monument for corner and accessories established to perpetuate locating the position of the corner:

Set 2 3/4" Cast Iron Monument with County Surveyor Cap.

South 28.68' Spike in Power Pole.
S 30° E 58.10' Spike in 10" Twin Oak
N 20° E 30.83' Spike in 12" Oak
North 27.90' Spike in 10" Twin Oak
N 40° E 78.30' Spike in 12" Oak
S 15° E 46.80' Spike in 10" Oak

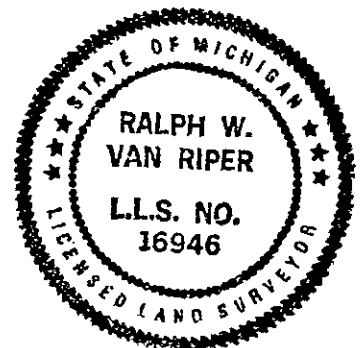

Signed by Ralph W. Van Riper Date 12/27/94
Surveyor's Michigan License No. 16946