

SURVEY &
REMONUMENTATION

MAR 21 1997

LIBEP 1952 PAGE 814

STATE OF MICHIGAN
COUNTY OF MUSKEGON
RECEIVED FOR RECORD

1996 DEC 30 AM 8:48

COMMISSION LAND CORNER RECORDATION CERTIFICATE
Filing Requirement of Act 74, Mich. P.A. 1970

For corners in
Muskegon
(County)

Located In:

Corner Code #

1. Public Land Survey T 11N R 17W L-13
T R
T R
T R
T R
2. Property Controlling S T R
in Section S T R
3. Miscellaneous S T R
Property in Sec. S T R

Carrie Carter
REGISTER OF DEEDS

A1843

Register of Deeds Stamp & File Number

4. Lot No. , Recorded Plat
5. Private Claims

I, Stanley H. Schackelford, P.S. in a field survey on OCTOBER 30, 1996, do hereby certify that under requirements of P.A. 74, Michigan P.A. of 1970, the corner points mentioned in lines 1 and 2 above were in conformance with regulations and rules therefore as required in the current manual of survey instructions of the United States Department of the Interior, Bureau of Land Management or by a decree of a Court of Law and/or that the corner points mentioned in lines 3, 4 and 5 above were in conformance with the rules of the Michigan Board of Land Surveyors or by a Decree of a Court of Law; established, re-established, monumented, re-monumented, recovered, found as expressed below:

NOTE: Not more than 4 corners, all in the same town and range, may be recorded on this certificate.

	A	B	C	D	E	F	G	H	I	J	K	L
2	6		5		4		3		2		1	
3												
4	7		8		9		10		11		12	
5												
6	18		17		16		15		14		13	
7												
8	19		20		21		22		23		24	
9												
10	30		29		28		27		26		25	
11												
12	31		32		33		34		35		36	
13												

A. Description of original monument and accessories and/or subsequent restoration:

1837-CORNER SET BY G.L.O. NORTH 66° EAST 30 LINKS 20" HEMLOCK
NORTH 58° 25 LINKS 20" HEMLOCK
MUSKEGON COUNTY ROAD COMMISSION WITNESS BOOK NO CORNER DESCRIPTION
NORTHEAST 42.60' 6 INCH POPLAR
WEST/NORTHWEST 139.50' 18 INCH MAPLE
EAST/SOUTHEAST 112.00' 6 INCH CHERRY
SOUTH 38.22' POWER POLE

"SEE ATTACHED EXHIBIT L-13"

B. Description of corner evidence found and/or method applied in restoring or reestablishing corner:


FOUND 4-INCH x 32-INCH CAST IRON MONUMENT WITH COUNTY SURVEYOR LEGEND IN ASPHALT
NORTH 75° WEST 139.50' 18 INCH MAPLE
SOUTH 70° EAST 112.00' 8 INCH CHERRY
SOUTH 34.22' POWER POLE
NORTH 10° EAST 42.60' 6 INCH POPLAR

CHECKS WITH SINGLE PROPORTIONATE MEASURE FOR MILE WITHIN 1 FOOT ±

POSITION OF SAID
RECORDED CORNER
REVIEWED & RATIFIED
BY MUSKEGON COUNTY
PEER GROUP IN ACCORDANCE
WITH THE ACT OF 1990

C. Description of monument for corner and accessories established to perpetuate locating the position of the corner:

FOUND 4-INCH x 32-INCH CAST IRON MONUMENT WITH COUNTY SURVEYOR LEGEND IN ASPHALT
NORTH 75° WEST 139.50' 18 INCH MAPLE FOUND SPIKE
SOUTH 70° EAST 112.00' 8 INCH CHERRY FOUND SPIKE
SOUTH 34.22' POWER POLE FOUND SPIKE
NORTH 10° EAST 42.60' 6 INCH POPLAR FOUND SPIKE

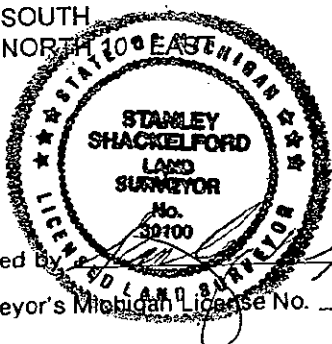

Signed by

Date

Surveyor's Michigan License No.

30100

FORM APPROVED BY MICHIGAN STATE BOARD OF LAND SURVEYORS, JAN. 28, 19
REVISED MAY 14, 19
REVISED JAN., 19

A1843

9.00

EXHIBIT L-13

1952 PAGE 815

1982 LIBER 1240, PAGE 544 FOUND 1½-INCH PIPE CHECKS WITH EXISTING WITNESSES BY C.F.L.

SET 4-INCH x 32-INCH CAST IRON MONUMENT WITH COUNTY SURVEYOR LEGEND IN ASPHALT

NORTH 75° WEST	139.50'
SOUTH 70° EAST	112.00'
SOUTH	34.22'
NORTH 10° EAST	42.60'

18 INCH MAPLE
8 INCH CHERRY
POWER POLE
6 INCH POPLAR