

51

LAND CORNER RECORDATION CERTIFICATE
Filing Requirement of Act 74, Mich. P.A. 1970

For corners in

Marquette
(County)

Located In:

Corner Code //

1. Public Land Survey T 45N R 24W H-1, I-1, I-2
T R
T R
T R
2. Property Controlling S T R
in Section S T R
3. Miscellaneous S T R
Property in Sec. S T R

Register of Deeds Stamp & File Number

4. Lot No. _____, Recorded Plat _____
5. Private Claims _____

	A	B	C	D	E	F	G	H	I	J	K	L	M
2	6		5		4		3		2		1		
3													
4	7		8		9		10		11		12		
5													
6	18		17		16		15		14		13		
7													
8	19		20		21		22		23		24		
9													
10	30		29		28		27		26		25		
11													
12	31		32		33		34		35		36		
13													

I, Paul Bressette, in a field survey on July 19, 1994, do hereby certify that under requirements of P.A. 74, Michigan P.A. of 1970, the corner points mentioned in lines 1 and 2 above were in conformance with regulations and rules therefore as required in the current manual of survey instructions of the United States Department of the Interior, Bureau of Land Management or by a decree of a Court of Law and/or that the corner points mentioned in lines 3, 4 and 5 above were in conformance with the rules of the Michigan Board of Land Surveyors or by a Decree of a Court of Law; established, re-established, monumented, re-monumented, recovered, found as expressed below:

NOTE: Not more than 4 corners, all in the same town and range, may be recorded on this certificate.

A. Description of original monument and accessories and/or subsequent restoration:


- H-1 Quarter Corner common to Sections 3 and 34. 1844: W.A. Burt, Deputy Surveyor. Set wood post witnessed by: Fir 8" N63E 28 links; Sugar 20" N25W 41 links.
I-1 Section Corner common to Sections 2, 3, 34 and 35. 1978: Charles F. Clark, RLS 25836. Found 3/4" iron pipe witnessed by: 8" Spruce N30E 2.55'; 6" Maple S30W 8.45'; 3" Maple S45E 5.12'.
I-2 Quarter Corner common to Sections 2 and 3. Marquette County Road Commission. Records show an iron bolt, no witnesses given.

B. Description of corner evidence found and/or method applied in restoring or reestablishing corner:

- H-1 No evidence of original survey or restoration found. Corner position re-established mid-point and on-line between the Northeast and Northwest Corners of Section 3.
I-1 Found iron pipe as described. Corner is also in records of Marquette County Road Commission, set from original bearing tree. Found one possible NBT from Road Commission and Clark's NBTs. Spruce is really a balsam and is dead and down. Replaced iron pipe with DNR monument and marked four new witnesses.
I-2 Found an iron bolt as described. Replaced iron bolt with DNR monument and witnessed.

C. Description of monument for corner and accessories established to perpetuate locating the position of the corner:

H-1 DNR Monument				I-1 DNR Monument				I-2 DNR Monument			
10" Sugar	N39°E	14.25'		6" R.Maple	N30°E	8.05'		8" Sugar	N34°E	2.5'	
6" Sugar	S59°E	31.35'		6" Sugar	S30°E	29.8'		5" Ironwood	S58°E	26.85'	
12" Sugar	S85°W	4.45'		12" Sugar	S52°W	29.8'		14" Sugar	S50°W	9.25'	
4" Sugar	N13°W	4.2'		6" Y.Birch	N49°W	25.7'		8" Sugar	N67°W	29.4'	

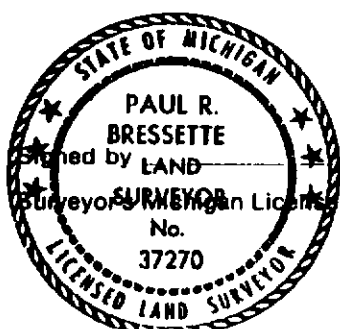

Paul R. Bressette Date _____
37270