

SURVEY &
REMONUMENTATION

JOB NUMBER: 94030

SHEET NO. : 1-534

For corners in

MARQUETTE
(County)

COMMISSION Located In:

Corner Code ##

1. Public Land Survey T 45N R 25W B-1
T R
T R
T R
T R
2. Property Controlling S T R
in Section S T R
3. Miscellaneous S T R
Property in Sec. S T R

4. Lot No. , Recorded Plat
5. Private Claims

I, GERALD W. CARLSON, in a field survey on Tuesday, December 13, 1994, do hereby certify that under requirements of P.A. 74, Michigan P.A. of 1970, the corner points mentioned in lines 1 and 2 above were in conformance with regulations and rules therefore as required in the current manual of survey instructions of the United States Department of the Interior, Bureau of Land Management or by a decree of a Court of Law and/or that the corner points mentioned in lines 3, 4 and 5 above were in conformance with the rules of the Michigan Board of Land Surveyors or by a Decree of a Court of Law; established, re-established, monumented, re-monumented, recovered, found as expressed below:

NOTE: Not more than 4 corners, all in the same town and range, may be recorded on this certificate.

A. Description of original monument and accessories and/or subsequent restoration:

B-1: Quarter Corner common to Section 6, T45N-R25W and Section 31, T46N-R25W. 1844: William A. Burt's original survey notes describe the corner monument as a wood post referenced by:
5" Spruce N62E, 22 l
4" Spruce N32W, 37 l

B. Description of corner evidence found and/or method applied in restoring or reestablishing corner:

1994- No original evidence found. C. Cummings in 1909 did not indicate any original evidence at this corner position as he ran the North line of Section 6 from the B.T. Corner at the NW Corner of Section 6 to the B.T. Corner at the NE Corner of Section 6. Set the corner proportionately on line between the NW and NE Corners of Section 6. SCA distance between section corners is 5171.27' as compared to the GLO distance of 5184.96' which is 13.69' short. Cummings mile distance is 5172'. DNR calculated mile distance is 5173.30'.

RATIFIED BY PEER GROUP
P.A. 345 OF 1990

Larry J. Busome
DATE Sept 26, 1994

C. Description of monument for corner and accessories established to perpetuate locating the position of the corner:

1994 - Set a 3/4" by 5' long iron capped with a 3 1/4" diameter aluminum tablet Marquette County Survey Monument stamped to identify the corner referenced by nails in:
4" Black Spruce N20E 12.59 ft.
5" Tamarack N56E 18.08 ft.
5" Tamarack S29E 17.43 ft.
4" Black Spruce S74W 15.30 ft.
Steel sign post North 1.6 ft.
Monument is 0.2' above ground and is set in a Black Spruce and Tamarack swamp roughly 950' North of a woods road.
Bk. 6, Pg 139

Signed by Gerald W. Carlson Date 12-22-94
Surveyor's Michigan License No. 24589

FORM APPROVED BY MICHIGAN STATE BOARD OF LAND SURVEYORS, JAN. 27, 1971
24589 REVISED MAY 17, 1975
REVISED JAN., 1983


MARQUETTE COUNTY
MICHIGAN
RECEIVED FOR RECORD

1994 DEC 28 PM 5:59

Patricia L. Moulton
REGISTER OF DEEDS

LIBER 1 PAGE 200
Register of Deeds Stamp & File Number

	A	B	C	D	E	F	G	H	I	J	K	L	M
2	6	5	4	3	2	1							
3													
4	7	8	9	10	11	12							
5													
6	18	17	16	15	14	13							
7													
8	19	20	21	22	23	24							
9													
10	30	29	28	27	26	25							
11													
12	31	32	33	34	35	36							
13													

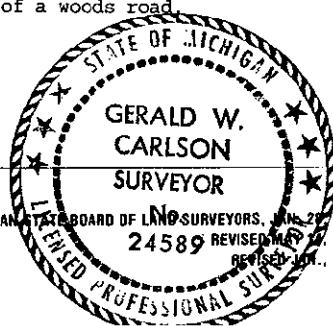

March 19 1939

B-13:
PART A CONTINUED:

SECTION

1939: Survey field notes by Schjonberg in M.C.R.C. F.B. #592 (no pg. given) indicate the corner as a 3/4" diameter pin. No accessories given.

No Date: M.C.R.C. Government Corner Index Book #641 for Section 6, T44N-R25W, indicates the corner as a 3/4" Iron Pin. No accessories given.

1961: The corner is shown on a Right-of-Way sketch recorded in L. 243, Deeds Pg. 104 as being an unknown distance West of Co. Rd. 557. No description of corner object or accessories given.

1977: An LCRC recorded by William R. Donnan P.S. #17618 in L. 1, RC Pg. 200, indicates no original corner evidence found. He set a 3/4" X 30" re-rod on-line between the N.W. and N.E. Corners of Section 6 at prorated government distance. Referenced by:

5" W. Birch	N13E,	8.50'	4" Maple	S54E,	2.80'
4" Maple	S40W,	11.49'			

1991: A Certificate of Survey recorded by Glenn C. Van Neste P.S. #27464 in L. 001, SM Pg. 660, indicates the corner as a found 3/4" Iron, 1.2' tall, 180' +/- West of C/L Perlin Bros. Trail per MCRC Field Notes of 1939. Distance N89-21'-28"E, 2641.00' to a found standard D.N.R. Monument at the S.E. Corner of Section 31. Distance N00-55'-39"E, 5324.35' to the North 1/4 Corner of Section 31. Found 3/4" Iron referenced by:

4" Spruce	Az 28,	9.12'	5" Maple	Az 136,11.55' (Donnan NBT)
7" W. Birch	Az 235,	10.60'	8" W. Birch	Az 313,11.71'
Iron #17618	Az 19.5,	41.20' (Donnan Corner Object)		