

1993

COMMISSION

JOB NUMBER: 93300
SHEET NO. : 1-379
For corners in

LAND CORNER RECORDATION CERTIFICATE
Filing Requirement of Act 74, Mich. P.A. 1970

MARQUETTE (County)		Located In:	Corner Code #
1. Public Land Survey	T 45N R 25W	MC M-9/10	✓
	T 45N R 24W	MC A-9/10	
	T R		
	T R		
2. Property Controlling in Section	S T R		
	S T R		
3. Miscellaneous Property in Sec.	S T R		
	S T R		

MARQUETTE COUNTY
MICHIGAN
RECEIVED FOR RECORD
1993 DEC 29 AM 10:35
1 PAGE 26
LIBER Register of Deeds Stamp & File Number

4. Lot No. , Recorded Plat
5. Private Claims

I, GERALD W. CARLSON, in a field survey on Thursday, December 23, 1993, do hereby certify that under requirements of P.A. 74, Michigan P.A. of 1970, the corner points mentioned in lines 1 and 2 above were in conformance with regulations and rules therefore as required in the current manual of survey instructions of the United States Department of the Interior, Bureau of Land Management or by a decree of a Court of Law and/or that the corner points mentioned in lines 3, 4 and 5 above were in conformance with the rules of the Michigan Board of Land Surveyors or by a Decree of a Court of Law; established, re-established, monumented, re-monumented, recovered, found as expressed below:

NOTE: Not more than 4 corners, all in the same town and range, may be recorded on this certificate.

	A	B	C	D	E	F	G	H	I	J	K	L	M
2	6		5		4		3		2		1		
3													
4	7		8		9		10		11		12		
5													
6	18		17		16		15		14		13		
7													
8	19		20		21		22		23		24		
9													
10	30		29		28		27		26		25		
11													
12	31		32		33		34		35		36		
13													

A. Description of original monument and accessories and/or subsequent restoration:

MC M-9: Meander Corner south of Section Corner common to Sections 24 and 25, T45N-R25W and Sections 19 and 30, T45N-R24W. 1844: William A. Burt's original survey notes describe the corner monument as a wood post referenced by:
8" W.Birch S13W, 18 l
(South shore of Little Lake)


1985 - C.F. Clark set a capped rebar on line between MC to the North and A-10 to the South, 33 ft. South of shoreline, found capped rebar (RLS No. 24589) East 13.52 ft. Meas. 1946.61 ft. to MC; calc. 1535.53 to A-10.
Referenced by:
NE corner "TT Camp" S30W 20.56 ft.
NW corner "TT Camp" S72W 45.62 ft.
Nail in 6" White Birch. N48W 12.02 ft.
Nail in 10" White Birch N63E 8.35 ft. (NBT's not blazed)

B. Description of corner evidence found and/or method applied in restoring or reestablishing corner:

1993 - Found 5/8 iron with RLS cap 24589 and 1/2" iron with RLS cap 25836/30091 approximately 13.5 ft. West. The 1/2" iron was determined to be on the line with the East 1/4 corner of Section 25, T45N-T25W and the W.C.M.C. Existing iron on the North shore of Little Lake. The line also is close to projecting into the East 1/4 corner of Section 24 making all four existing irons close to a straight line. Replaced the Clark 1/2" iron with a Marquette County Survey Monument. Peer group ratification 12-20-93.

C. Description of monument for corner and accessories established to perpetuate locating the position of the corner:

1993 - Replaced 1/2" iron with RLS cap 25836/30091 with a 2 1/8" diameter aluminum pipe capped with a 3 1/4" diameter aluminum tablet Marquette County Survey Monument stamped to identify the corner referenced by nails in:
8" White Birch N45W 11.99 ft. Clark NBT
21" White Pine N16E 23.94 ft.
10" White Birch N66E 8.37 ft. Clark NBT
9" White Pine S05W 62.35 ft.
Monument is 0.30 ft. above ground. 32 ft. +/- South of the waters edge of Little Lake, 8 ft. South of the crest of the hill, 28 ft. +/- North of a log cabin (main bldg.) 15 ft. East of log cabin (main bldg.). Bk. 6, Pg. 6

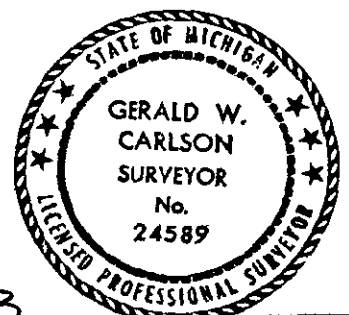

Signed by Gerald W. Carlson Date 12-28-93
Surveyor's Michigan License No. 24589