

MICHIGAN
DEPARTMENT OF CONSERVATION
FORESTRY DIVISION

LAND CORNER RECORD

T. 45 N.R. 26 W


Marquette COUNTY

DESCRIPTION OF CORNER 1/4 Corner between Sections 29 and 32

CORNER MONUMENT 1" Pipe with 4" Brass Cap

DATE MONUMENT PLACED AND WITNESSED 1/16/61 with R. Hinds, Engr. Aide B.

WITNESSES TO CORNER..... 24" W. Pine (1/4s NBT) N 84° W 21 Links

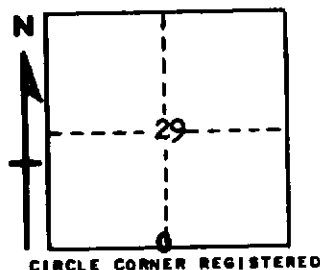

22" W. Pine (1/4s NBT) N 60° E 55 1/2 Links

AND

DESCRIPTION IN DETAIL AS TO HOW CORNER WAS LOCATED AND IDENTIFIED OR RESTORED.

This corner was replaced from one Cedar B.T. (down) in poor condition. Position checks with marsh to West. 1/4 Corner lies 15 links south of a straight line between Section Corners.

SURVEYOR'S SEAL

SIGNED Billy D. Buckler DATE 2/21/61
REGISTERED LAND SURVEYOR
Billy D. Buckler