

MICHIGAN
DEPARTMENT OF CONSERVATION
FORESTRY DIVISION

LAND CORNER RECORD

T. 45N N.R. 27W


Marquette COUNTY

DESCRIPTION OF CORNER 1/4 corner bet. Secs. 34-35

CORNER MONUMENT 1" pipe with 4" aluminum cap.

DATE MONUMENT PLACED AND WITNESSED 9/15/66

WITNESSES TO CORNER..... 9" B. Spruce (1/4 S 34/35 NBT) S66°W 15.2'

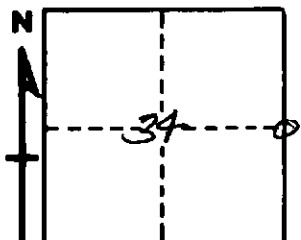

8" B. Spruce (1/4 S NBT) S30°W 55.5'

AND

CIRCLE CORNER REGISTERED

DESCRIPTION IN DETAIL AS TO HOW CORNER WAS LOCATED AND IDENTIFIED OR RESTORED.

This corner re-established by proportionate measure and on line
bet. sec. cor. north and meander cor. south.

Found no evidence of original corner.

Corner lies on north margin of an island of spruce and balsam
timber and in low, wet land.

SURVEYOR'S SEAL

SIGNED Billy D. Buckler DATE 1/11/67
REGISTERED LAND SURVEYOR