

MICHIGAN
DEPARTMENT OF CONSERVATION
FORESTRY DIVISION

LAND CORNER RECORD

T. 45N N.R. 27W


Marquette COUNTY

DESCRIPTION OF CORNER 1/4 corner bet. secs. 11-14

CORNER MONUMENT 1" pipe with 4" aluminum cap.

DATE MONUMENT PLACED AND WITNESSED 9/21/66

WITNESSES TO CORNER..... 10" Red Oak ($\frac{1}{2}$ S NBT) S75°E 70.3'

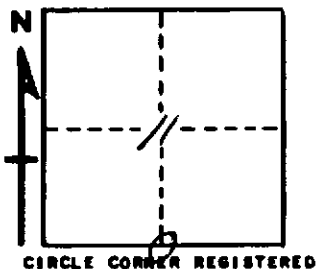

8" Red Oak ($\frac{1}{2}$ S NBT) S45°W 27.2'

AND

DESCRIPTION IN DETAIL AS TO HOW CORNER WAS LOCATED AND IDENTIFIED OR RESTORED.

This corner re-established from one w.pine bearing N52E 36 lks. Tree, down, burned and in poor condition. No positive evidence of original cor.

Corner lies on top of east end of ridge, from southwest.

SURVEYOR'S SEAL

SIGNED Billy D. Buckler DATE 1/11/67
REGISTERED LAND SURVEYOR