

MICHIGAN
DEPARTMENT OF CONSERVATION
FORESTRY DIVISION

LAND CORNER RECORD

T. 45N R. 27W


Marquette COUNTY

DESCRIPTION OF CORNER 1/4 Cor. bet. Secs. 10-11

CORNER MONUMENT 1" pipe with 4" aluminum cap.

DATE MONUMENT PLACED AND WITNESSED 8/19/66

WITNESSES TO CORNER..... 12" W. Pine (1/4 S NBT) N33°W 35.5'

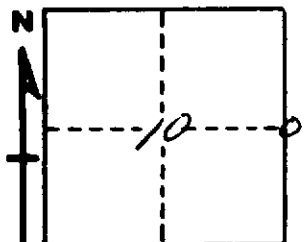

12" R. Oak (1/4 S NBT) S75°W 14.0'

AND

CIRCLE CORNER REGISTERED

DESCRIPTION IN DETAIL AS TO HOW CORNER WAS LOCATED AND IDENTIFIED OR RESTORED.

This corner replaced at location of an old W. Pine post placed by unknown surveyor, years ago.

Found line north and south of corner about seven years old.

SURVEYOR'S SEAL

SIGNED Billy D. Buckler DATE 1/11/67
REGISTERED LAND SURVEYOR