

RP

MARQUETTE COUNTY
MICHIGAN
RECEIVED FOR RECORD
1999 DEC 22 AM 11:25

SECTION

LAND CORNER RECORDATION CERTIFICATE
Filing Requirement of Act 74, Mich. P.A. 1970

For corners in
MARQUETTE
(County)

Located In: Corner Code #

1. Public Land Survey	T <u>46N</u> R <u>25W</u>	<u>H-1</u>
	T _____ R _____	_____
	T _____ R _____	_____
	T _____ R _____	_____
2. Property Controlling in Section	S _____ T _____ R _____	_____
	S _____ T _____ R _____	_____
3. Miscellaneous	S _____ T _____ R _____	_____
Property in Sec.	S _____ T _____ R _____	_____
4. Lot No. _____, Recorded Plat _____		
5. Private Claims _____		

Patricia A. Monley
REGISTER OF DEEDS

LIBER **R2** PAGE **211**
Register of Deeds Stamp & File Number

I, GERALD W. CARLSON, in a field survey on October, 19 99, do hereby state that under requirements of P.A. 74, Michigan P.A. of 1970, the corner points mentioned in lines 1 and 2 above were in conformance with regulations and rules therefore as required in the current manual of survey instructions of the United States Department of the Interior, Bureau of Land Management or by a decree of a Court of Law and/or that the corner points mentioned in lines 3, 4 and 5 above were in conformance with the rules of the Michigan Board of Land Surveyors or by a Decree of a Court of Law; established, re-established, monumented, recovered, found as expressed below:

NOTE: Not more than 2 corners, all in the same town and range, may be recorded on this certificate.

A. Description of original monument and accessories and/or subsequent restoration:
H-1: North Quarter Corner of Section 3, T46N-R25W.
1999: Not part of original survey.

B. Description of corner evidence found and/or method applied in restoring or reestablishing corner:
H-1: 1999: Corner position established by single proportionate measurement between the Northwest and Northeast corners of Section 3 on line between the South quarter corner and the Southwest corner of Section 34, T47N-R25W. Distances are 2646.42' West and 2646.42' East along the North Township Line of T46N-R25W to the Northwest and Northeast corners of Section 3. The South quarter corner of Section 34, T47N-R25W is East 19.85'.

C. Description of monument for corner and accessories established to perpetuate locating the position of the corner:
H-1: 1999: Set a 2 3/8" O.D. aluminum pipe capped with a 3 1/4" diameter aluminum tablet Marquette County Survey Monument stamped to identify the corner. Monument is flush with the ground. Referenced by:
8" Jack Pine S71E, 42.16' 9" Jack Pine S12W, 49.17'
11" White Birch N79W, 29.53' 10" Jack Pine S20W, 59.88'
S 1/4 Section 34 47-25 (sc) S88E, 19.85'


Green Steel Sign Post w/ Yellow Survey Marker Sign N02W, 2.95'

Note: Bearing trees have painted face, butt, and side nail blazes, d.h. measuring nails, and stamped B.T. Tags affixed.
Bk. 12, Pg. 148 T46N-R25W Corner Search Sheet 99100

	A	B	C	D	E	F	G	H	I	J	K	L	M
1													
2	6		5		4		3		2		1		
3													
4	7		8		9		10		11		12		
5													
6	13		17		16		15		14		13		
7													
8	19		20		21		22		23		24		
9													
10	30		29		28		27		26		25		
11													
12	31		32		33		34		35		36		
13													

RATIFIED BY PEER GROUP
P.A. 345 OF 1990

Larry J. Bassme
DATE 11/1/99

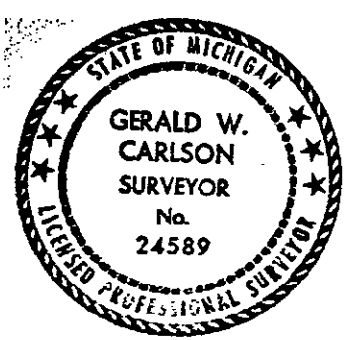

Signed by Gerald W. Carlson Date 12-8-99

Surveyor's Michigan License No. 24589