

# LAND CORNER RECORDATION CERTIFICATE Filing Requirement of Act 74, Mich. P.A. 1970

For corners in

Marquette

(County)

Located in:

Corner Code #

1. Public Land Survey

T 47N R 25W

J7

T R

T R

T R

2. Property Controlling  
in Section

S 14

T 47N R 25W

16

3. Miscellaneous  
Property in Sec.

S

T R

S

T R

Register of Deeds Stamp &amp; File Number

4. Lot No. \_\_\_\_\_, Recorded Plat \_\_\_\_\_

5. Private Claims \_\_\_\_\_

16 Jul 09 1996

J7 Jun 27 1995

I, Paul R. Bressette, in a field survey on \_\_\_\_\_, 19\_\_\_\_ do hereby state that under requirements of P.A. 74, Michigan P.A. of 1970, the corner points mentioned in lines 1 and 2 above were in conformance with regulations and rules therefore as required in the current manual of survey instructions of the United States Department of the Interior, Bureau of Land Management or by a decree of a Court of Law and/or that the corner points mentioned in lines 3, 4 and 5 above were in conformance with the rules of the Michigan Board of Land Surveyors or by a Decree of a Court of Law; established, re-established, monumented, recovered, found as expressed below:

NOTE: Not more than 2 corners, all in the same town and range, may be recorded on this certificate.

	A	B	C	D	E	F	G	H	I	J	K	L	M
1													
2		6		5		4		3		2		1	
3													
4		7		8		9		10		11		12	
5													
6		18		17		16		15		14		13	
7													
8		19		20		21		22		23		24	
9													
10		30		29		28		27		26		25	
11													
12		31		32		33		34		35		36	
13													

## A. Description of original monument and accessories and/or subsequent restoration:

(J7) Quarter corner common to Sections 14 and 23. 1852: Martin M. Hall, D.S. Hemlock 15 for Quarter corner, no witnesses. 1942: Marquette County Road Commission: Set 1" iron pipe and cedar post in remains of windfallen hemlock showing old blazed faces and corresponding with creek intersection 1.5 chains west witnessed by: 7" W.Birch N20W 5.6'; 9" W.Birch S78E 8.9'. 1987: Bill Robey, RLS (MCRC). Found iron pipe and rewitnessed: 6" Cedar S31W 9.36'; 10" Hemlock N35E 9.62'; 10" W.Birch (old NBT) N02W 6.15'.  
(16) East One-sixteenth corner common to Sections 14 and 23. 1940's: Marquette County Road Commission. Field Book 628 p.33 shows set 1" iron pipe.

## B. Description of corner evidence found and/or method applied in restoring or reestablishing corner:

(J7) Found 1" iron pipe and witnesses as described. Remains of the windfallen hemlock still evident, but decayed to point where no blazes are evident. Corner falls on SW facing slope. Iron pipe was replaced with DNR monument set flush with the ground and is accepted as a careful and faithful PERPETUATION of the position of the original corner.

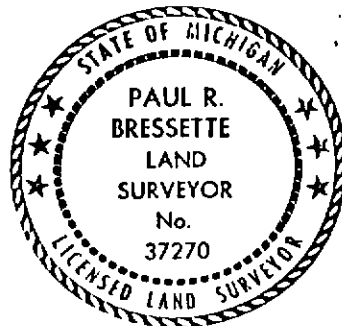
(16) Found 1" iron pipe as described. Rejected pipe due excessive distance from calculated position. Pipe falls 2.64 feet Easterly of calculated position. Corner position established mid-point and on-line between the South Quarter and Southeast corners of Section 14.

## C. Description of monument for corner and accessories established to perpetuate locating the position of the corner:

(J7) 1" iron pipe w/4" aluminum cap	(16) DNR monument
*10" Hemlock N34E 9.34' (1/4S,NBT)	06" R.Maple N31E 40.3' (1/16S,BT)
05" Cedar S21E 19.45' (1/4S,NBT)	08" R.Maple S75E 17.85' (1/16S,BT)
*06" Cedar S27W 9.48' (1/4S,NBT)	12" Spruce S33W 25.4' (1/16S,BT)
08" Hemlock N76W 18.25' (1/4S,NBT)	08" R.Maple N54W 23.3' (1/16S,BT)

\* denotes MCRC witness. All trees are blazed, scribed and painted. Measurements are to notch in butt blaze except "\*" are made to nail in side of tree. Bearings are magnetic.

All trees are blazed, scribed and painted. Measurements are to notch in butt blaze, bearings are magnetic.

Signed by Paul R. BressetteDate 1-13-97Surveyor's Michigan License No. 37270

For the Michigan Department of Natural Resources - Forest Management Division