

LAND CORNER RECORDATION CERTIFICATE
Filing Requirement of Act 74, Mich. P.A. 1970

For corners in

Marquette

(County)

Located in:

Corner Code #

1. Public Land Survey

T 47N R 25N

H9

T R

T R

T R

2. Property Controlling
in Section

S 22

T 47N R 25N

15

T R

3. Miscellaneous

S

T R

Property in Sec.

S

T R

Register of Deeds Stamp & File Number

4. Lot No. , Recorded Plat

5. Private Claims

15 Jun 26 1996

H9 Jun 25 1996

I, Paul R. Bressette, in a field survey on 19 do hereby state that under requirements of P.A. 74, Michigan P.A. of 1970, the corner points mentioned in lines 1 and 2 above were in conformance with regulations and rules therefore as required in the current manual of survey instructions of the United States Department of the Interior, Bureau of Land Management or by a decree of a Court of Law and for that the corner points mentioned in lines 3, 4 and 5 above were in conformance with the rules of the Michigan Board of Land Surveyors or by a Decree of a Court of Law; established, re-established, monumented, recovered, found as expressed below:

NOTE: Not more than 2 corners, all in the same town and range, may be recorded on this certificate.

	A	B	C	D	E	F	G	H	I	J	K	L	M
1													
2	6		5		4		3		2		1		
3													
4	7		8		9		10		11		12		
5													
6	18		17		16		15		14		13		
7													
8	19		20		21		22		23		24		
9													
10	30		29		28		27		26		25		
11													
12	31		32		33		34		35		36		
13													

A. Description of original monument and accessories and/or subsequent restoration:

(H9) Quarter corner common to Sections 22 and 27. 1852: A.D. Sullivan, D.S. Set wood post witnessed by: B. Oak 10 S02W 39 links; Y. Pine 18 N85E 08 links.

(15) West One-sixteenth corner common to Sections 22 and 27. Not set in original survey, no evidence of subsequent establishment.

B. Description of corner evidence found and/or method applied in restoring or reestablishing corner:

(H9) No evidence of original survey or restoration found. Lots of pine stumps in area, but no marks are evident. Ski trail construction has taken place in the immediate vicinity of the corner. Corner falls in southwest edge of the ski trail. Corner position reestablished mid-point and on-line between the Southeast and Southwest corners of Section 22, and is accepted as a careful and faithful REESTABLISHMENT of the position of the original corner.

(15) Corner position established mid-point and on-line between the Southwest and South Quarter corners of Section 22.

C. Description of monument for corner and accessories established to perpetuate locating the position of the corner:

(H9) 1" iron pipe w/4" aluminum cap

(15) DNR monument

14" R. Pine N57E 52.2' (1/4S,NBT)

8" R. Pine N06E 25.55' (1/16S,BT)

14" R. Pine S56E 71.2' (1/4S,NBT)

6" R. Pine S66E 26.15' (1/16S,BT)

22" R. Pine S15W 18.65' (1/4S,NBT)


9" W. Pine S21W 40.3' (1/16S,BT)

13" R. Pine N72W 25.9' (1/4S,NBT)

9" R. Pine N69W 90.5' (1/16S,BT)

All trees are blazed, scribed and painted. Measurements are to notch in butt blaze, bearings are magnetic. A wood post with location tag is 10 feet west of corner.

All trees are blazed, scribed and painted. Measurements are to notch in butt blaze, bearings are magnetic.

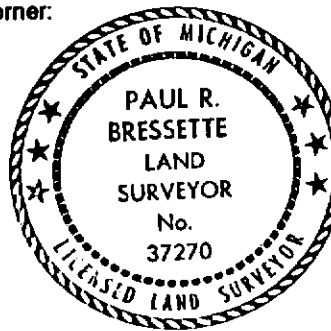

Signed by Paul R. Bressette

Date 1-13-97

Surveyor's Michigan License No. 37270

For the Michigan Department of Natural Resources - Forest Management Division