

APR 01 1996

JOB NUMBER: 95053  
SHEET NO. : 1-619

LAND CORNER RECORDATION CERTIFICATE  
Filing Requirement of Act 74, Mich. P.A. 1970

MARQUETTE COUNTY  
MICHIGAN  
RECEIVED FOR RECORD

1995 DEC 27 AM 7:44

For corners in

MARQUETTE  
(County)

Located In:

Corner Code #

1. Public Land Survey

T 47N R 26W

M-4

T 47N R 25W

A-4

2. Property Controlling  
in Section

S T R

3. Miscellaneous

S T R

Property in Section

S T R

4. Lot No. , Recorded Plat

5. Private Claims

Patricia A. Moseley  
REGISTER OF DEEDS

LIBER

1 PAGE 237

Register of Deeds Stamp & File Number

I, GERALD W. CARLSON, in a field survey on Tuesday, November 28, 1995

do hereby certify that under requirements of P.A. 74, Michigan P.A. of 1970, the corner points mentioned in lines 1 and 2 above were in conformance with regulations and rules therefore as required in the current manual of survey instructions of the United States Department of the Interior, Bureau of Land Management or by a decree of a Court of Law and/or that the corner points mentioned in lines 3, 4 and 5 above were in conformance with the rules of the Michigan Board of Professional Surveyors or by a Decree of a Court of Law; established, re-established, monumented, re-monumented, recovered, found as expressed below:

NOTE: Not more than 4 corners, all in the same town and range, may be recorded on this certificate.

A. Description of original monument and accessories and/or subsequent restoration:

M-4: Quarter Corner common to Section 12, T47N-R26W and No Date: The corner is shown on an easement map recorded Section 7, T47N-R25W. 1844: William A. Burt's original survey notes describe the corner monument as a wood post referenced by:

12" Maple N53E, 20 l

12" Hemlock S85W, 20 l

No Date: The corner is indicated on an easement map recorded in L. 297, Deeds Pg. 569.

No Date: The corner is shown on an easement map recorded in L. 290, Deeds Pg. 224.

B. Description of corner evidence found and/or method applied in restoring or reestablishing corner:

1995: Searched and no subsequent evidence or corner found. Corner position established by single proportion measurement on line between the N.E. and S.E. Corners of Section 12. Leave Swamp line call (Rec. = 231') measured @ 210' South of monument. Distances North and South are 2627.38.

RATIFIED BY PEER GROUP  
P.A. 345 OF 1990

Larry J. Busome  
DATE 11/6/95

C. Description of monument for corner and accessories established to perpetuate locating the position of the corner:

1995: Set a 2 3/8" O.D. aluminum pipe capped with a 3 1/4" diameter aluminum tablet Marquette County Survey Monument stamped to identify the corner. Monument is 1" above ground. Established references using double headed nails in:

8" Maple S67E, 2.15'

7" Spruce S10E, 7.60'


11" Maple S49W, 8.07'

10" Maple N02E, 9.37'

Green Steel Sign Post w/Yellow Survey Marker Sign South, 1.0'

Note: Bearing trees were face and butt blazed, painted, and had B.T. tags affixed.

Bk. 9, pp. 71-72.

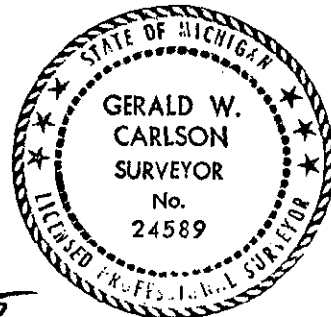

Signed by Gerald W. Carlson

Date 12-15-95

Surveyor's Michigan License No. 24589

FORM APPROVED BY MICHIGAN STATE BOARD OF PROFESSIONAL SURVEYORS, JAN. 28, 1971  
REVISED MAY 14, 1975  
REVISED JAN., 1983