

JOB NUMBER: 93300  
SHEET NO. : 1-345  
For corners in

COMMISSION

LAND CORNER RECORDATION CERTIFICATE  
Filing Requirement of Act 74, Mich. P.A. 1970

MARQUETTE  
(County)

Located In:

Corner Code #

1. Public Land Survey

T 48N R 25W

A-13

T 48N R 26W

M-13

T 47N R 25W

A-1

T 47N R 26W

M-1

2. Property Controlling  
in Section

S

T

R

S

T

R

3. Miscellaneous  
Property in Sec.

S

T

R

S

T

R

4. Lot No. , Recorded Plat

5. Private Claims

I, GERALD W. CARLSON, in a field survey on Saturday, December 4, 1993, do hereby certify that under requirements of P.A. 74, Michigan P.A. of 1970, the corner points mentioned in lines 1 and 2 above were in conformance with regulations and rules therefore as required in the current manual of survey instructions of the United States Department of the Interior, Bureau of Land Management or by a decree of a Court of Law and/or that the corner points mentioned in lines 3, 4 and 5 above were in conformance with the rules of the Michigan Board of Land Surveyors or by a Decree of a Court of Law; established, re-established, monumented, re-monumented, recovered, found as expressed below:

NOTE: Not more than 4 corners, all in the same town and range, may be recorded on this certificate.

A. Description of original monument and accessories and/or subsequent restoration:

A-13: Section Corner common to Section 31, T48N-R25W;  
Section 6, T47N-R25W; Section 36, T48N-R26W; and Section 1,  
T47N-R26W. 1845: William A. Burt's original survey notes  
describe the corner as a wood post referenced by:  
24" Hemlock N79W, 75 1  
20" W.Pine S63E, 45 1

No date given - Cummings recorded survey indicates the  
SW corner of Section 31 verified by bearing trees. This  
distance North of this corner is listed at 2640, the  
distance East from this corner is listed at 2456.3.  
No date given - Marquette County Road Commission book  
indicates a pipe at corner of old fence. No corner  
accessories given. (See reverse side)

B. Description of corner evidence found and/or method applied in restoring or reestablishing corner:

1993 - Found a P-K set from George Wilson's witnesses. Chipped asphalt out and found 1 1/2" iron pipe 1.10 ft. below surface of asphalt. Also found cap for 5/8" iron buried next to pipe with RLS #17618. Set a 3/4" rebar 18" long inside 1 1/2" diameter pipe in Payne & Dolan road. Set a Marquette County Survey Monument on top of 3/4" rebar in monument box. Tablet is 0.6 below surface of road. Distance North is 4.73 ft. short of Cummings, distance East measures 2.45 ft. short of Cummings. Peer group ratification 11-29-93.

C. Description of monument for corner and accessories established to perpetuate locating the position of the corner:

1993 - Set 3/4" rebar 18" long inside 1 1/2" diameter pipe with Marquette County Survey Monument cap on top of 3/4" rebar stamped to identify the corner in a monument box in the black top of Payne & Dolan Road referenced by nails in:  
8" Maple N62E 94.20 ft.  
9" Spruce S33E 89.30 ft.  
Power Pole S53W 72.4 ft. Donnan witness  
Power Pole N88W 109.50 ft.

The power poles are the Southeasterly poles of the Northwesterly two group of three poles of three groups of three poles at a PI in the power line. Monument is 0.6 ft. below surface of the road.

Bk. 3, Pg. 140

Signed by

Gerald W. Carlson

Date


12-22-93

Surveyor's Michigan License No.

24589

FORM APPROVED BY MICHIGAN STATE BOARD OF LAND SURVEYORS.

24589

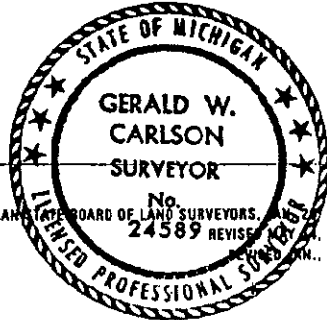

Record No. 345

Part "A" Continued:

1972 - William Donnan found a 1 1/4" iron pipe

5" Maple	N70°E	50.89 ft.
12" Tamarack	S75°E	59.67 ft.
Power Pole	S51°W	72.54 ft.

This corner not recorded.

1976 - George Wilson recorded a old iron pipe with iron rod inside with RLS cap 17618 that lines up with an old fence line running easterly from corner referenced by:

Face of a power pole	S65°W	82.90 ft.
Face of a power pole	S10°W	85.90 ft.

L1 RC, Pg. 143

67483  
#900  
1/10/11