

SURVEY & REMONUMENTATION

OCT 26 1993

COMMISSION

LAND CORNER RECORDATION CERTIFICATE Filing Requirement of Act 74, Mich. P.A. 1970

Approved by Menominee County
Land Survey Remonumentation
Peer Group Under Act 345 Of
P.A. Of 1990 On SEPT 16, 19993
Mc-Drui RLS
Chairman (ACTING)


For corners in

MENOMINEE
(County)

Located In:

Corner Code #

- | | | |
|------------------------------------|---------------------------|------------|
| 1. Public Land Survey | T <u>32N</u> R <u>27W</u> | <u>L-1</u> |
| | T _____ R _____ | _____ |
| | T _____ R _____ | _____ |
| | T _____ R _____ | _____ |
| 2. Property Controlling in Section | S _____ T _____ R _____ | _____ |
| | S _____ T _____ R _____ | _____ |
| 3. Miscellaneous Property in Sec. | S _____ T _____ R _____ | _____ |
| | S _____ T _____ R _____ | _____ |

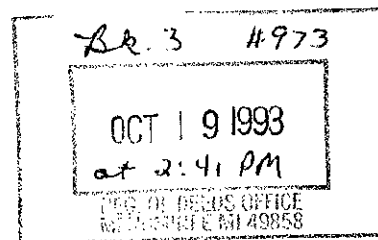

Register of Deeds Stamp & File Number

4. Lot No. _____, Recorded Plat _____
5. Private Claims _____

I, William Lenca, in a field survey on July, 19 93, do hereby certify that under requirements of P.A. 74, Michigan P.A. of 1970, the corner points mentioned in lines 1 and 2 above were in conformance with regulations and rules therefore as required in the current manual of survey instructions of the United States Department of the Interior, Bureau of Land Management or by a decree of a Court of Law and/or that the corner points mentioned in lines 3, 4 and 5 above were in conformance with the rules of the Michigan Board of Land Surveyors or by a Decree of a Court of Law; established, re-established, monumented, re-monumented, recovered, found as expressed below:

NOTE: Not more than 4 corners, all in the same town and range, may be recorded on this certificate.

A. Description of original monument and accessories and/or subsequent restoration:

ORIGINAL B.T.'s:

Cedar, 6", N20°E, 40 lks
Hemlock, 12", N40°W, 9 lks

Original Survey by James H. Mullett in 1848. All original evidence for this corner has been destroyed by County Road improvements.

B. Description of corner evidence found and/or method applied in restoring or reestablishing corner:

Found $\frac{1}{2}$ " dia. Iron Rod/Identification cap set by George B. Wilson (RLS 17607). Corner position is in line with an old fence North and fits closely with being on a straight line between Section Corners. The corner falls on the North side of County Road No. 320 (E-W), and is accepted as the best available evidence of the position of the original corner.

C. Description of monument for corner and accessories established to perpetuate locating the position of the corner:

Set 5/8" x 24" Iron Rod/3 $\frac{1}{4}$ " Alum. cap stamped for corner:

12" dia. White Pine	N35°W	21.00 feet
10" dia. White Pine	N42°E	64.50 feet
9" dia. Cedar	S29°E	58.68 feet
$\frac{1}{2}$ " dia. Iron @ Steel Sign Post	South	33.00 feet

NOTE: All bearings are magnetic bearings; distances are measured with steel tape.

Signed by William Lenca

Date Sept. 10, 1993

Surveyor's Michigan License No. 26461

