

SURVEY &  
REMONUMENTATION

OCT 26 1993

COMMISSION

LAND CORNER RECORDATION CERTIFICATE

Filing Requirement of Act 74, Mich. P.A. 1970

For corners in

MENOMINEE  
(County)

Located In:

Corner Code #

1. Public Land Survey T 32N R 27W M-1  
T \_\_\_\_\_ R \_\_\_\_\_  
T \_\_\_\_\_ R \_\_\_\_\_  
T \_\_\_\_\_ R \_\_\_\_\_  
2. Property Controlling S \_\_\_\_\_ T \_\_\_\_\_ R \_\_\_\_\_  
in Section S \_\_\_\_\_ T \_\_\_\_\_ R \_\_\_\_\_  
3. Miscellaneous S \_\_\_\_\_ T \_\_\_\_\_ R \_\_\_\_\_  
Property in Sec. S \_\_\_\_\_ T \_\_\_\_\_ R \_\_\_\_\_  
4. Lot No. \_\_\_\_\_, Recorded Plat \_\_\_\_\_  
5. Private Claims \_\_\_\_\_

I, William Lenca, in a field survey on July, 1993, do hereby certify that under requirements of P.A. 74, Michigan P.A. of 1970, the corner points mentioned in lines 1 and 2 above were in conformance with regulations and rules therefore as required in the current manual of survey instructions of the United States Department of the Interior, Bureau of Land Management or by a decree of a Court of Law and/or that the corner points mentioned in lines 3, 4 and 5 above were in conformance with the rules of the Michigan Board of Land Surveyors or by a Decree of a Court of Law; established, re-established, monumented, re-monumented, recovered, found as expressed below:

**NOTE: Not more than 4 corners, all in the same town and range, may be recorded on this certificate.**

A. Description of original monument and accessories and/or subsequent restoration:

ORIGINAL B.T.'s:

Cedar, 14", N40°W, 20 lks  
Tamarack, 15", S40°W, 18 lks

Original Survey by James H. Mullett in 1848. All original evidence for this corner has been destroyed by county road improvements.

B. Description of corner evidence found and/or method applied in restoring or reestablishing corner:

Found 30" Alum. monument/4" dia. Alum. cap in centerline of County Road 320 (East-West) and County Road 571 (North-South). This corner was set by George B. Wilson, RLS No. 17607, in about 1979. This survey has been used for control in several surveys and is accepted as the best evidence of the position of the original corner.

C. Description of monument for corner and accessories established to perpetuate locating the position of the corner:


30" Aluminum Monument/4" dia. Aluminum cap stamped for corner:

5" White Ash	N25°E	120.98 feet
9" dia. Cedar	S57°E	102.00 feet
8" dia. White Ash	S56°W	100.68 feet
7" dia. Cedar	N35°W	117.20 feet
Steel Fence Post	N43°W	71.4 feet

**NOTE:** All bearings are magnetic bearings; all distances are measured with steel tape; distances to trees are measured to nails in center of tree.

Approved by Menominee County  
Land Survey Remonumentation  
Peer Group Under Act 345 Of

P.A. Of 1990 On OCT 6, 19993  
M. HANLI RLS  
Chairman (ACTING)

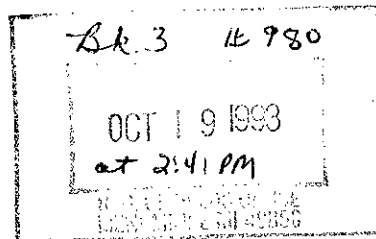

Register of Deeds Stamp & File Number

	A	B	C	D	E	F	G	H	I	J	K	L	M
2	6		5		4		3		2		1		
3													
4	7		8		9		10		11		12		
5													
6	18		17		16		15		14		13		
7													
8	19		20		21		22		23		24		
9													
10	30		29		28		27		26		25		
11													
12	31		32		33		34		35		36		
13													

Signed by William Lenca Date Sept. 20, 1993

Surveyor's Michigan License No. 26461

