

# SURVEY & REMONUMENTATION

OCT 27 1999

SECTION

## LAND CORNER RECORDATION CERTIFICATE Filing Requirement of Act 74, Mich. P.A. 1970

Approved by Menominee County  
Land Survey Remonumentation  
Peer Group Under Act 345 Of  
PA. Of 1990 On 10/11 1999  
Mike Davis RLS  
Chairman

For corners in

MENOMINEE  
(County)

Located In:

Corner Code #

1. Public Land Survey

T33N R 26W B-7

T R

T R

T R

2. Property Controlling  
in Section

S T R

S T R

3. Miscellaneous  
Property in Sec.

S T R

S T R

4. Lot No. \_\_\_\_\_, Recorded Plat \_\_\_\_\_

5. Private Claims \_\_\_\_\_

RECEIVED FOR RECORD  
39 OCT 15 PM 1:40  
PAGE # 02 BK 6  
BARBARA MORRISON  
REGISTER OF DEEDS  
MENOMINEE MI 49855

Register of Deeds Stamp & File Number

I, William Lenca, in a field survey on Mar., 1999 do hereby state that under requirements of P.A. 74, Michigan P.A. of 1970, the corner points mentioned in lines 1 and 2 above were in conformance with regulations and rules therefore as required in the current manual of survey instructions of the United States Department of the Interior, Bureau of Land Management or by a decree of a Court of Law and/or that the corner points mentioned in lines 3, 4 and 5 above were in conformance with the rules of the Michigan Board of Land Surveyors or by a Decree of a Court of Law; established, re-established, monumented, recovered, found as expressed below:

NOTE: Not more than 2 corners, all in the same town and range, may be recorded on this certificate.

	A	B	C	D	E	F	G	H	I	J	K	L	M
1													
2		6		5		4		3		2		1	
3													
4		7		8		9		10		11		12	
5													
6		18		17		16		15		14		13	
7													
8		19		20		21		22		23		24	
9													
10		30		29		28		27		26		25	
11													
12		31		32		33		34		35		36	
13													

A. Description of original monument and accessories and/or subsequent restoration:

1848: Original Survey by James H. Mullett - B.T.'s - Birch, 8" - S01°E - 10 lks.; Black Ash, 10" - N02°W - 14 lks. All original evidence for this corner has been destroyed by farming activities.

1901: Survey by Albert Hass, Co. Surveyor, shows this corner as it relates to other corners in Section 18. Survey states "Set 4" Cedar post from Gov. B.T.

1987: L.C.R.C. No. 772 by William Lenca, RLS No. 26461 - Found remains of post at intersection of old fences N-S and E-W - set 1" x 18" Iron Pipe - TIES: W. Birch, 7" - N12°W - 5.06'; Black Ash, 4" - S80°E - 17.10'; W. Birch, 6" - S20°W - 34.30'.


B. Description of corner evidence found and/or method applied in restoring or reestablishing corner:

We found a 1 inch diameter x 18 inch iron pipe and 3 B.T.'s as described in L.C.R.C. No. 772 (see part "A"). The pipe is located at the intersection of ancient fences running North - South - East - West. We also found the point and remains of an old squared wood post at the corner location. From the age of the fences, it appears that they were built from the 1901 survey by Albert Hass. We accepted the remains of the old squared wood post as the corner set by Albert Hass. Since Hass stated that he set this corner from a Government B.T., we accepted this corner as a careful and faithful perpetuation of the position of the original corner.

C. Description of monument for corner and accessories established to perpetuate locating the position of the corner:

Set 2" dia. Aluminum Pipe 30" long/3-1/4" dia. Alum cap stamped for corner location:

6" dia. White Ash	N46°E	11.10 feet	Scr. NBT
6" dia. White Ash	S29°E	21.65 feet	Scr. NBT
8" dia. White Ash	S48°W	33.31 feet	Scr. NBT
10" dia. White Birch (Ex. B.T.)	N54°W	30.99 feet	Scr. NBT
Metal Survey Sign Post	South	1.0 feet	

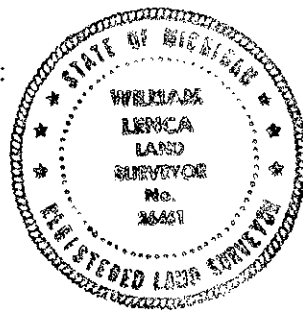

NOTE: All bearings are magnetic bearings. All distances are measured with steel tape. Distances to trees are to nail in side of tree.

Signed by William Lenca  
Surveyor's Michigan License No. 26461

Date Aug. 31, 1999