

LAND CORNER RECORDATION CERTIFICATE
Filing Requirement of Act 74, Mich. P.A. 1970

For corners in
Menominee

(County)	Located In:	Corner Code #
1. Public Land Survey	T 34N R 26W	L2
	T R	
	T R	
	T R	
2. Property Controlling in Section	S 1 T 34N R 26W	9
	S 1 T 34N R 26W	12
3. Miscellaneous Property in Sec.	S T R	
	S T R	

Register of Deeds Stamp & File Number

4. Lot No. , Recorded Plat
5. Private Claims

I, Paul R. Bressette, in a field survey on 12 April 10, 1995, 1995, do hereby certify that under requirements of P.A. 74, Michigan P.A. of 1970, the corner points mentioned in lines 1 and 2 above were in conformance with regulations and rules therefore as required in the current manual of survey instructions of the United States Department of the Interior, Bureau of Land Management or by a decree of a Court of Law and/or that the corner points mentioned in lines 3, 4 and 5 above were in conformance with the rules of the Michigan Board of Land Surveyors or by a Decree of a Court of Law; established, re-established, monumented, re-monumented, recovered, found as expressed below:

NOTE: Not more than 4 corners, all in the same town and range, may be recorded on this certificate.

	A	B	C	D	E	F	G	H	I	J	K	L	M
2	6		5		4		3		2				
3													
4	7		8		9		10		11		12		
5													
6	18		17		16		15		14		13		
7													
8	19		20		21		22		23		24		
9													
10	30		29		28		27		26		25		
11													
12	31		32		33		34		35		36		
13													

A. Description of original monument and accessories and/or subsequent restoration:


- (L2) Center Quarter corner of Section 1. Not set in original survey, no evidence of subsequent establishment.
- (9) East One-sixteenth corner of Section 1. Not set in original survey, no evidence of subsequent establishment.
- (12) South One-sixteenth corner of Section 1. Not set in original survey, no evidence of subsequent establishment.

B. Description of corner evidence found and/or method applied in restoring or reestablishing corner:

- (L2) Corner position established at the intersection of the east-west and north-south Quarter lines of Section 1. Apple BT has PK nail with DNR reference tag in side.
- (9) Corner position established mid-point and on-line between the East and Center Quarter corners of Section 1.
- (12) Corner position established mid-point and on-line between the South and Center Quarter corners of Section 1.

C. Description of monument for corner and accessories established to perpetuate locating the position of the corner:

(L2) DNR monument	(9) DNR monument	(12) DNR monument
4" Apple N18E 89.2'	8" Ash N13E 21.95'	10" Cedar N76E 25.7'
4" W. Pine S02W 142.05'	7" Cedar S49E 22.35'	6" Tamarack S44E 39.4'
18" Sugar S31W 88.15'	7" Cedar S63W 17.7'	6" Tamarack S71W 34.85'
6" W. Pine N26W 78.1'	7" Cedar N53W 37.85'	6" Tamarack N30W 75.1'

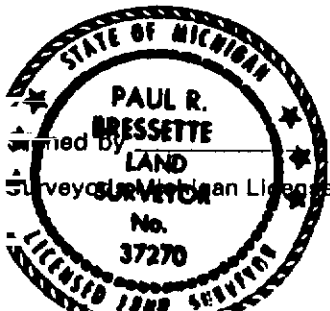

Paul R. Bressette Date 11-15-95
37270
For the Michigan Department of Natural Resources - Forest Management Division