

SECTION

APR 06 1999

Approved by Menominee County
Land Survey Remonumentation
Peer Group Under Act 345 Of

PA. OF 1990 On 12/14 1998
Chairman

LAND CORNER RECORDATION CERTIFICATE
Filing Requirement of Act 74, Mich. P.A. 1970

For corners in

MENOMINEE
(County)

1. Public Land Survey
2. Property Controlling in Section
3. Miscellaneous Property in Sec.

Located In: T34N R26W
S T R
S T R
S T R
S T R


Corner Code # C-02

RECEIVED FOR RECORD
98 DEC 14 PM 3:22
PAGE # 685 BK 5
BARDARA NORMAN
REGISTER OF DEEDS
MENOMINEE MI 49863

Register of Deeds Stamp & File Number

4. Lot No. _____, Recorded Plat _____
5. Private Claims _____

I, William Lenca, in a field survey on Sept. 24, 1998 do hereby state that under requirements of P.A. 74, Michigan P.A. of 1970, the corner points mentioned in lines 1 and 2 above were in conformance with regulations and rules therefore as required in the current manual of survey instructions of the United States Department of the Interior, Bureau of Land Management or by a decree of a Court of Law and/or that the corner points mentioned in lines 3, 4 and 5 above were in conformance with the rules of the Michigan Board of Land Surveyors or by a Decree of a Court of Law; established, re-established, monumented, recovered, found as expressed below:

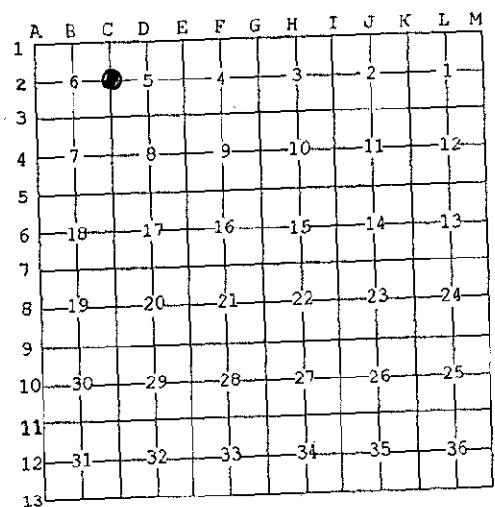

NOTE: Not more than 2 corners, all in the same town and range, may be recorded on this certificate.

A. Description of original monument and accessories and/or subsequent restoration:
1848: Original Survey by James H. Mullett - B.T.'s - Hemlock, 6" - N25°E - 10 lks.; Fir, 10" - S22°E - 22 lks. All original evidence for this corner has been destroyed by farming activities.

B. Description of corner evidence found and/or method applied in restoring or reestablishing corner:
We set a 3/4" x 4' aluminum rod/3-1/4" aluminum cap at an ancient fence corner. Fences are running North and East. This position agrees well with a G.L.O. swamp call 0.5 chain to the south, fits closely with being midpoint on line between section corners, matches existing lines of occupation, and is accepted as the best available evidence of the position of the original corner.



C. Description of monument for corner and accessories established to perpetuate locating the position of the corner:
Set 3/4" dia. x 4' long aluminum rod/3-1/4" dia. Alum. cap stamped for corner.

11" dia. Cedar	N32°E	26.40 feet	"X" cut in upper and lower blazes
5" dia. Cedar	S48°E	7.58 feet	"X" cut in upper and lower blazes
9" dia. Cedar	S35°W	23.59 feet	"X" cut in upper and lower blazes
9" dia. Cedar	N60°W	6.74 feet	"X" cut in upper and lower blazes
Metal Survey Sign Post	West	1.0 feet	

NOTE: All bearings are magnetic bearings. All distances are measured with steel tape. Distances to trees are to nail in side of tree.

Signed by William Lenca
Surveyor's Michigan License No. 26461

Date Dec. 11, 1998