

LAND CORNER RECORDATION CERTIFICATE
 Filing Requirement of Act 74, Mich. P.A. 1970 as Amended

For corners in

<u>Menominee</u> (County)	Located In:	Corner Code #
1. Public Land Survey	T 34N R 29W	I02
	T 34N R 29W	J03
	T _____ R _____	_____
2. Property Controlling in Section	S _____ T _____ R _____	_____
	S _____ T _____ R _____	_____
	S _____ T _____ R _____	_____
3. Miscellaneous Property in Sec.	S _____ T _____ R _____	_____
	S _____ T _____ R _____	_____
4. Lot No. _____, Recorded Plat _____		
5. Private Claims _____		

Register of Deeds Stamp & File Number

A	B	C	D	E	F	G	H	I	J	K	L	M
1												
2	6	5	4	3	2	1						
3												
4	7	8	9	10	11	12						
5												
6	18	17	16	15	14	13						
7												
8	19	20	21	22	23	24						
9												
10	30	29	28	27	26	25						
11												
12	31	32	33	34	35	36						
13												

I, Jeremy J. Pipp, in a field survey on 3/26/2012AD do hereby state that under requirements of P.A. 74, Michigan P.A. of 1970, the corner points mentioned in lines 1 and 2 above were in conformance with regulations and rules therefore as required in the current manual of survey instructions of the United States Department of the Interior, Bureau of Land Management or by a decree of a Court of Law and /or that the corner points mentioned in lines 3, 4 and 5 above were in conformance with the rules of the Michigan Board of Land Surveyors or by a Decree of a Court of Law; established, re-established, monumented, recovered, found as expressed below:

NOTE: Not more than 2 corners, all in the same town and range, may be recorded on this certificate.

A. Description of original monument and accessories and/or subsequent restoration:

(I02) Quarter Corner common to Sections 2 and 3. 1852: Francis Coleman, DS. Set wood post witnessed by: Forked Black Oak 20 N56E 9 links (5.94'); White Birch 6 S77W 18 links (11.88'); 1994: Michigan DNR (Paul Bressette PS#37270) set DNR monument witnessed by: 8" Red Maple N24E 25.7', 5" Red Maple S31E 22.65', 10" Red Maple S05W 28.4', 6" Red Maple N33W 39.0'.

(J03) Quarter Corner common to Sections 2 and 11. 1852: Francis Coleman, DS. Set wood post witnessed by: Cedar 6 N53W 15 links (9.90'); Cedar 6 S76E 15 links (9.90'); 1994: Michigan DNR (Paul Bressette PS#37270) set DNR monument witnessed by: 12" Red Maple N65E 41.45', Cedar Post SE 1.1', 4" Red Maple S43W 22.7', 10" Red Maple N66W 16.0'.

B. Description of corner evidence found and/or method applied in restoring or reestablishing corner:

(I02) Accepted found MDNR Monument and Four existing Witnesses as a careful and faithful REESTABLISHMENT of the position of the original corner.


(J03) Accepted found MDNR Monument and Four existing Witnesses as a careful and faithful REESTABLISHMENT of the position of the original corner.

C. Description of monument for corner and accessories established to perpetuate locating the position of the corner:

(I02) DNR monument	(J03) DNR monument
EX. 9" Maple N26E 26.05' (1/4S,NBT)	5" Ash N21E 29.95' (1/4S,NBT)
EX. 7" Maple S32E 22.74' (1/4S,NBT)	EX. 17" Maple N64E 41.93' (1/4S,NBT)
EX. 14" Maple S06W 28.62' (1/4S,NBT)	5" Red Maple S02W 22.25' (1/4S,NBT)
EX. 9" Maple N31W 39.02' (1/4S,NBT)	EX. 14" Maple N63W 16.25' (1/4S,NBT)

All trees are blazed, scribed, painted, and signed. Measurements are to nail in side of tree, bearings are magnetic. A metal rail & sign were set North 1.5 feet.

Signed by Jeremy J. Pipp Date July 16, 2012
 Surveyor's Michigan License No. 50447

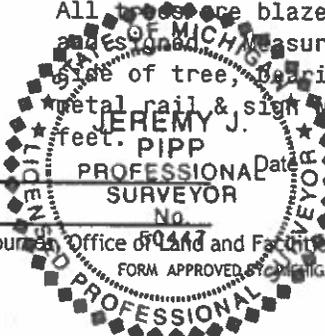

For the Michigan Department of Natural Resources and Environment Office of Land and Fisheries