

101

LAND CORNER RECORDATION CERTIFICATE
Filing Requirement of Act 74, Mich. P.A. 1970

For corners in
Menominee
(County)

Located In:

Corner Code //

- | | | | | |
|-------------------------|---|-----|---|-----------|
| 1. Public Land Survey | T | --- | R | --- |
| | T | --- | R | --- |
| | T | --- | R | --- |
| | T | --- | R | --- |
| 2. Property Controlling | S | 1 | T | 35N R 25W |
| in Section | S | 1 | T | 35N R 25W |
| 3. Miscellaneous | S | --- | T | --- |
| Property in Sec. | S | --- | T | --- |

Register of Deeds Stamp & File Number

4. Lot No. _____, Recorded Plat _____
5. Private Claims _____

I, Paul R. Bressette, in a field survey on March 05, 1996, 19_____, do hereby certify that under requirements of P.A. 74, Michigan P.A. of 1970, the corner points mentioned in lines 1 and 2 above were in conformance with regulations and rules therefore as required in the current manual of survey instructions of the United States Department of the Interior, Bureau of Land Management or by a decree of a Court of Law and/or that the corner points mentioned in lines 3, 4 and 5 above were in conformance with the rules of the Michigan Board of Land Surveyors or by a Decree of a Court of Law; established, re-established, monumented, re-monumented, recovered, found as expressed below.

NOTE: Not more than 4 corners, all in the same town and range, may be recorded on this certificate.

	A	B	C	D	E	F	G	H	I	J	K	L	M
2	6		5		4		3		2				
3													
4	7		8		9		10		11		12		
5													
6	18		17		16		15		14		13		
7													
8	19		20		21		22		23		24		
9													
10	30		29		28		27		26		25		
11													
12	31		32		33		34		35		36		
13													

A. Description of original monument and accessories and/or subsequent restoration:


- (6) Northeast One-sixteenth corner of Section 1. Found 1 1/2" iron pipe approximately 100 feet east of calculated position. Rejected due to excessive distance from proper position.
- (7) North One-sixteenth corner on the East line of Section 1. Not set in original survey, no evidence of subsequent establishment. This corner controls in Section 1 only, not in Section 6 of T35N, R24W.

B. Description of corner evidence found and/or method applied in restoring or reestablishing corner:

- (6) Corner position established at the intersection of the North and East One-sixteenth lines of Section 1.
- (7) Corner position established mid-point and on-line between the Northeast and East Quarter corners of Section 1.

C. Description of monument for corner and accessories established to perpetuate locating the position of the corner:

- | | |
|---|---|
| (6) 1" iron pipe w/ 4" aluminum cap | (7) 1" iron pipe w/ 4" aluminum cap |
| 13" Cedar N88E 21.2' | 11" Cedar S42W 11.1' |
| 11" Cedar S31E 26.1' | 9" Cedar N86W 48.6' |
| 9" Cedar N88W 42.3' | 7" Cedar N54W 73.55' |
| 11" Cedar N18W 39.0' | 7" Cedar N01W 27.0' |
| All trees are blazed, scribed (1/16S,BT) and painted. Measurements are to notch in butt blaze. Bearings are magnetic. | All trees are blazed, scribed (1/16S,BT) and painted. Measurements are to notch in butt blaze. Bearings are magnetic. |

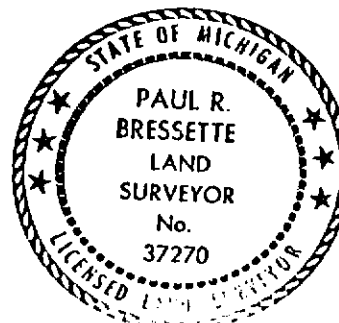

Signed by Paul R. Bressette Date 8-14-96

Surveyor's Michigan License No. 37270

For the Michigan Department of Natural Resources - Forest Management Division

FORM APPROVED BY MICHIGAN STATE BOARD OF LAND SURVEYORS, JAN. 28, 1971
REVISED MAY 14, 1975
REVISED JAN., 1983