

SURVEY & REMONUMENTATION

JAN 09 2001

SECTION

LAND CORNER RECORDATION CERTIFICATE
Filing Requirement of Act 74, Mich. P.A. 1970

Approved by Menominee County
Land Survey Remonumentation
Peer Group Under Act 345 of
P.A. Of 1990 On 7/13, 2000
MA DAWN RLS
Chairman

For corners in
MENOMINEE

(County)

Located In:

Corner Code #

1. Public Land Survey

T 35N 26W C-5

T R

T R

T R

2. Property Controlling
in Section

S T R

S T R

3. Miscellaneous
Property in Sec.

S T R

S T R

4. Lot No. , Recorded Plat

5. Private Claims

I, William Lenca, in a field survey on Sep., 19 00 do hereby state that under requirements of P.A. 74, Michigan P.A. of 1970, the corner points mentioned in lines 1 and 2 above were in conformance with regulations and rules therefore as required in the current manual of survey instructions of the United States Department of the Interior, Bureau of Land Management or by a decree of a Court of Law and /or that the corner points mentioned in lines 3, 4 and 5 above were in conformance with the rules of the Michigan Board of Land Surveyors or by a Decree of a Court of Law; established, re-established, monumented, recovered, found as expressed below:

NOTE: Not more than 2 corners, all in the same town and range, may be recorded on this certificate.

A. Description of original monument and accessories and/or subsequent restoration:

1848: Original Survey by James H. Mullett - B.T.'s - Beech, 10" - N28°W - 14 lks.; Beech, 14" - N45°E - 17 lks. All original evidence for this corner has been destroyed by County Road improvements.

1988: Certified Survey No. 592 by William Lenca, RLS No. 26461, shows this corner as it relates to other corners in the NE1/4 of Section 18, T35N-R26W.

B. Description of corner evidence found and/or method applied in restoring or reestablishing corner:

We recovered a Railroad Spike in the centerline of county roads running East - West and North. This position fits with measurements shown in Certified Survey No. 592, and is accepted as the best available evidence of the position of the original corner.

C. Description of monument for corner and accessories established to perpetuate locating the position of the corner:

Set 5/8" x 24" Iron Rod/3-1/4" dia. Alum. cap stamped for corner location in Monument Box:

5/8" x 24" Iron Rod/2" dia. Alum. cap marked "WITNESS MARKER"

5/8" x 24" Iron Rod/2" dia. Alum. cap marked "WITNESS MARKER"

Metal Survey Sign Post


Nothing Else Nearby

South 28.21 feet

N35°W 51.38 feet

N35°W 52.4 feet

1.0' East of Power Pole
at Survey Sign Post

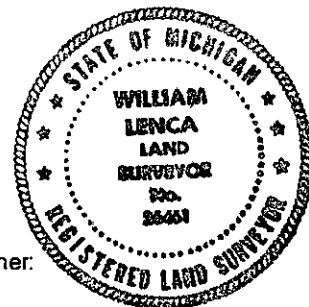

NOTE: All bearings are magnetic bearings. All distances are measured with steel tape. Distances to trees are to nail in side of tree.

Signed by William Lenca

Date Oct. 13, 2000

Surveyor's Michigan License No. 26461