

MAR 29 2000

SECTION

LAND CORNER RECORDATION CERTIFICATE
Filing Requirement of Act 74, Mich. P.A. 1970

Approved by Menominee County
Land Survey Remonumentation
Peer Group Under Act 345 Of
P.A. Of 1990 On 401, 1992
M.H. Dwyer P.C.S.
Chairman

For corners in

MENOMINEE

(County)

Located in:

Corner Code #

1. Public Land Survey

T 35NR 27W A-06

T R

TR

T R

2. Property Controlling in Section

S **T** **R**

S T R

3. Miscellaneous Property in Sec

S T R

S T R

4. Lot No. _____, Recorded Plat _____

5. Private Claims

(SAME AS CORNER M-06 T35N - R28W)

I, William Lenca, in a field survey on FEB., 19 99 do hereby state that under requirements of P.A. 74, Michigan P.A. of 1970, the corner points mentioned in lines 1 and 2 above were in conformance with regulations and rules therefore as required in the current manual of survey instructions of the United States Department of the Interior, Bureau of Land Management or by a decree of a Court of Law and /or that the corner points mentioned in lines 3, 4 and 5 above were in conformance with the rules of the Michigan Board of Land Surveyors or by a Decree of a Court of Law; established, re-established, monumented, recovered, found as expressed below:

NOTE: Not more than 2 corners, all in the same town and range, may be recorded on this certificate.

[illegible]

A. Description of original monument and accessories and/or subsequent restoration:

1847: Original Survey by H. Floyd - B.T.'s - Cedar, 14" - N63°W - 40 lks.; Cedar, 15" - S41°W - 28 lks. All original evidence for this corner has been destroyed by logging activities.

B. Description of corner evidence found and/or method applied in restoring or reestablishing corner:

In a retracement of the West Line of Section 18, T35N-R27W, we found an ancient fence corner at a distance of 2658.68 feet south of the NW Corner of said Section. There is no evidence at the SW Corner of Section 18, but the distance from this fence corner to the W1/4 Corner of Section 19 is 5286.54 feet. Since the measurements to corners North and South of the ancient fence corner fit well, we accepted it as the best available evidence of the position of the original corner.

C. Description of monument for corner and accessories established to perpetuate locating the position of the corner:

Set 3/4" dia. x 4' long aluminum rod/3-1/4" dia. Alum. cap stamped for corner.


16" dia. W. Pine S 31° E 52.45 feet Scr. NBT

9" dia. Hemlock S 35° W 13.49 feet Scr. NBT

10" dia. Cedar N 60° W 64.23 feet Scr. NBT

11" dia. Cedar N 20° W 41.48 feet Scr. NBT

Metal Survey Sign Post	West	1.0 feet
------------------------	------	----------

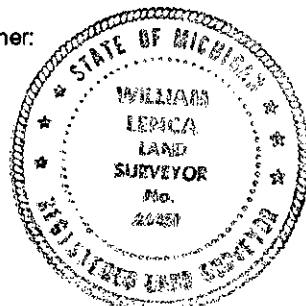

NOTE: All bearings are magnetic bearings. All distances are measured with steel tape. Distances to trees are to nail in side of tree.

Signed by D. J. Jones

Date Oct. 28, 1999

Surveyor's Michigan License No. 26461