

LAND CORNER RECORDATION CERTIFICATE
Filing Requirement of Act 74, Mich. P.A. 1970

For corners in

MENOMINEE
(County)

Located In:

Corner Code: 47

1. Public Land Survey

T 35N R 27W

K-3

2. Property Controlling
in Section

S T R


3. Miscellaneous
Property in Sec.

S T R

4. Lot No. , Recorded Plat

5. Private Claims

Register of Deeds Stamp & File Number

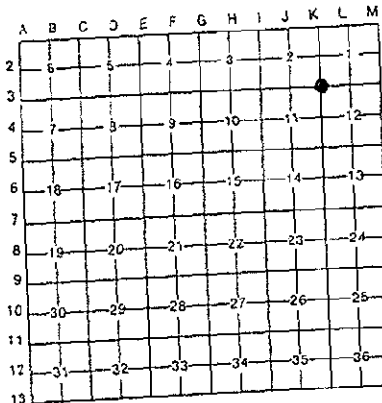

I, William Lenca, in a field survey on Aug. 22, 1995, do hereby certify that under requirements of P.A. 74, Michigan P.A. of 1970, the corner points mentioned in lines 1 and 2 above were in conformance with regulations and rules therefore as required in the current manual of survey instructions of the United States Department of the Interior, Bureau of Land Management or by a decree of a Court of Law and/or that the corner points mentioned in lines 3, 4 and 5 above were in conformance with the rules of the Michigan Board of Land Surveyors or by a Decree of a Court of Law, established, re-established, monumented, re-monumented, recovered, found as expressed below:

NOTE: Not more than 4 corners, all in the same town and range, may be recorded on this certificate.

A. Description of original monument and accessories and/or subsequent restoration:

1848: Original Survey by James H. Mullett - B.T.'s - Cedar, 12" - S60°W - 13 lks; Cedar, 14" - S73°W - 10 lks. All original evidence for this corner has been destroyed by county road improvements.

1983: Certified Survey No. 356 recorded by George B. Wilson, RLS No. 17607, shows this corner as it relates to the E1/4 Corner of Section 2, T35N-R27W.

B. Description of corner evidence found and/or method applied in restoring or reestablishing corner:

In an August, 1995 survey of Section 1, T35N-R27W, we found a 1" diameter iron pipe in the centerline of a North - South County Road, and in line with ancient fences running East and West from this location. The position of the iron pipe fits well with Wilson's record distance to the 1/4 Corner to the North, as shown in Certified Survey No. 356. The measured distance to Corner K-2 (W1/4 Cor. of Sec. 1) is 2650.96' (GLO = 2640) The measured distance to Corner L-3 (S1/4 Corner of Sec. 1) is 2629.81' (GLO = 2644.3') This corner position has been used consistently for several years by local surveyors, and is accepted as the best available evidence of the position of the original corner.

C. Description of monument for corner and accessories established to perpetuate locating the position of the corner:

Set 2" dia. Aluminum Pipe/3-1/4" dia. Alum cap stamped for corner location:

6" dia. Cedar	S72°E	46.85 feet	Scr NBT
5" dia. Cedar	S20°E	59.50 feet	Scr NBT
9" dia. Cedar	S64°W	48.32 feet	Scr NBT
5" dia. White Ash	N47°W	63.21 feet	Scr NBT

NOTE: All bearings are magnetic bearings. All distances are measured with a steel tape. Distances to trees are to nail in side of tree.

Signed by W. Lenca Date Sept. 06, 1995

Surveyor's Michigan License No. 26461

