

LAND CORNER RECORDATION CERTIFICATE
Filing Requirement of Act 74, Mich. P.A. 1970 as Amended

for corners in

Menominee (County)	Located In:	Corner Code #
1. Public Land Survey	T 40N R 26W	I07
	T 40N R 26W	J07
	T R	
2. Property Controlling in Section	S T R	
	S T R	
	S T R	
3. Miscellaneous Property in Sec.	S T R	
	S T R	
	S T R	

4. Lot No. _____, Recorded Plat _____
5. Private Claims _____

_____ 7/02/2013AD
do hereby state
that under requirements of P.A. 74, Michigan P.A. of 1970, the corner points mentioned in lines 1 and 2
above were in conformance with regulations and rules therefore as required in the current manual of survey
instructions of the United States Department of the Interior, Bureau of Land Management or by a decree of a
Court of Law and /or that the corner points mentioned in lines 3, 4 and 5 above were in conformance with
the rules of the Michigan Board of Land Surveyors or by a Decree of a Court of Law; established, re-
established, monumented, recovered, found as expressed below:

NOTE: Not more than 2 corners, all in the same town and range, may be recorded
on this certificate.

A. Description of original monument and accessories and/or subsequent restoration:

(I07) Section corner common to Sections 14, 15, 22, and 23. 1852: Harvey Mellen, DS. Set Section corner post witnessed by Cedar 18 S28W 3 links (1.98'), Cedar 18 N28E 3 links (1.98'). 1964: Kimberly Clark (Neal Sperhake PS#7876) Set 1" pipe with 4" Aluminum cap witnessed by Cedar 8" S84E 28 1/2 links (18.81'), Cedar 10 N26E 20 links (13.20'), Cedar 9 N66W 23 links (15.18').

(J07) Quarter corner common to Sections 14 and 23. 1852: Harvey Mellen, DS. Set Qr. Section post witnessed by W. Pine 24 S40E 20 links (13.20'), W. Pine 18 S72W 19 links (12.54'). 1958: Michigan DNR (Billy Buckler PS#8887) Set 1" pipe with 4" Brass cap witnessed by 18" W. Pine N42W 38 links (25.08'), 14" Red Pine S19E 66 links (43.56').

B. Description of corner evidence found and/or method applied in restoring or reestablishing corner:

(I07) Accepted found Kimberly Clark Monument (and remains of OBT & three NBT's) as a careful and faithful PERPETUATION of the position of the original corner.

(J07) Accepted found MDNR Monument as a careful and faithful PERPETUATION of the position of the original corner.

C. Description of monument for corner and accessories established to perpetuate locating the position of the corner:


(I07)	Kimberly Clark monument	(J07)	DNR monument
11" Cedar	N39E 43.04' (S14,NBT)	5" R. Pine	N21E 9.07' (1/4S,NBT)
6" Tamarack	S37E 9.62' (S23,NBT)	3" Maple	S31E 6.76' (1/4S,NBT)
5" Tamarack	S70W 24.54' (S22,NBT)	4" W. Pine	S21W 14.78' (1/4S,NBT)
6" Tamarack	N57W 15.54' (S15,NBT)	11" R. Pine	N70W 39.75' (1/4S,NBT)
All trees are blazed, scribed, painted, and signed. Measurements are to nail in side of tree, bearings are magnetic. A metal sign post was set North 1.5 feet.		All trees are blazed, scribed, painted, and signed. Measurements are to nail in side of tree, bearings are magnetic. A metal sign post was set East 1.5 feet.	

Signed by _____ Date _____ August 08, 2013
Surveyor's Michigan License No. _____ 50447

For the Michigan Department of Natural Resources Forest Resources Division

20248

20247

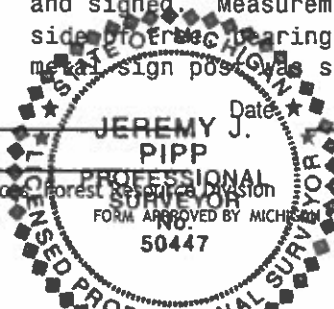

Revised May 14, 1975
Revised Jan., 1983
Revised Oct., 1995