

LAND CORNER RECORDATION CERTIFICATE  
Filing Requirement of Act 74, Mich. P.A. 1970 as Amended

For corners in

| Menominee<br>(County)                 | Located In:   | Corner Code #           |
|---------------------------------------|---|-------------------------|
| 1. Public Land Survey                 | T _____ R _____<br>T _____ R _____<br>T _____ R _____           | _____<br>_____<br>_____ |
| 2. Property Controlling<br>in Section | S 26 T 41N R 25W<br>S 26 T 41N R 25W<br>S _____ T _____ R _____ | 3<br>4<br>_____         |
| 3. Miscellaneous<br>Property in Sec.  | S _____ T _____ R _____<br>S _____ T _____ R _____              | _____<br>_____          |
| 4. Lot No. _____, Recorded Plat _____ |   |                         |
| 5. Private Claims _____               |   |                         |

Register of Deeds Stamp & File Number

|    |    |   |    |   |    |   |    |   |    |   |    |   |   |
|----|----|---|----|---|----|---|----|---|----|---|----|---|---|
| 1  | A  | B | C  | D | E  | F | G  | H | I  | J | K  | L | M |
| 2  | 6  |   | 5  |   | 4  |   | 3  |   | 2  |   | 1  |   |   |
| 3  |    |   |    |   |    |   |    |   |    |   |    |   |   |
| 4  | 7  |   | 8  |   | 9  |   | 10 |   | 11 |   | 12 |   |   |
| 5  |    |   |    |   |    |   |    |   |    |   |    |   |   |
| 6  | 18 |   | 17 |   | 16 |   | 15 |   | 14 |   | 13 |   |   |
| 7  |    |   |    |   |    |   |    |   |    |   |    |   |   |
| 8  | 19 |   | 20 |   | 21 |   | 22 |   | 23 |   | 24 |   |   |
| 9  |    |   |    |   |    |   |    |   |    |   |    |   |   |
| 10 | 30 |   | 29 |   | 28 |   | 27 |   | 26 |   | 25 |   |   |
| 11 |    |   |    |   |    |   |    |   |    |   |    |   |   |
| 12 | 31 |   | 32 |   | 33 |   | 34 |   | 35 |   | 36 |   |   |
| 13 |    |   |    |   |    |   |    |   |    |   |    |   |   |

I, Jeremy J. Pipp, in a field survey on 12/28/2011AD do hereby state  
that under requirements of P.A. 74, Michigan P.A. of 1970, the corner points mentioned in lines 1 and 2  
above were in conformance with regulations and rules therefore as required in the current manual of survey  
instructions of the United States Department of the Interior, Bureau of Land Management or by a decree of  
a Court of Law and /or that the corner points mentioned in lines 3, 4 and 5 above were in conformance with  
the rules of the Michigan Board of Land Surveyors or by a Decree of a Court of Law; established,  
re-established, monumented, recovered, found as expressed below:

NOTE: Not more than 2 corners, all in the same town and range, may be recorded  
on this certificate.

A. Description of original monument and accessories and/or subsequent restoration:

(03) North One-Sixteenth corner common to Sections 26 and 27. Not set in original  
survey, no evidence of subsequent establishment.

(04) Northwest One-Sixteenth corner of Section 26. Not set in original survey, no  
evidence of subsequent establishment.

B. Description of corner evidence found and/or method applied in restoring or reestablishing corner:

(03) Corner position established mid-point and on-line between the West One-Quarter  
corner and the Northwest corner of Section 26.

(04) Corner position established at the intersection of the North and West One-Sixteenth  
lines of Section 26.

C. Description of monument for corner and accessories established to perpetuate locating the position of the corner:


|  |                        |  |                        |
|--|------------------------|--|------------------------|
| (03)   | DNR monument           | (04)   | DNR monument           |
| 5" Maple   | N22E 39.90' (1/16S,BT) | 7" Cedar   | S86E 22.57' (1/16S,BT) |
| 7" Maple   | S45E 10.1' (1/16S,BT)  | 8" Cedar   | S11E 18.98' (1/16S,BT) |
| 10" Maple  | S50W 30.9' (1/16S,BT)  | 4" Ash   | S46W 16.10' (1/16S,BT) |
| 7" Maple   | N66W 22.45' (1/16S,BT) | 11" Cedar  | N37W 10.55' (1/16S,BT) |
| All trees are blazed, scribed, and<br>painted. Measurements are to nail in<br>side of tree, bearings are magnetic. |                        | All trees are blazed, scribed, and<br>painted. Measurements are to nail in<br>side of tree, bearings are magnetic. |                        |

Signed by Jeremy J. Pipp Date July 16, 2012  
Surveyor's Michigan License No. 50447

For the Michigan Department of Natural Resources, Office of Surveying and Mapping

20001

20002

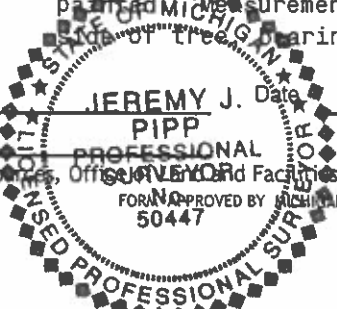

APPROVED BY MICHIGAN STATE BOARD OF PROFESSIONAL SURVEYORS, JAN. 28, 1971  
Revised May 14, 1975  
Revised Jan., 1983  
Revised Oct., 1995