

LAND CORNER RECORDATION CERTIFICATE
Filing Requirement of Act 74, Mich. P.A. 1970 as Amended

or corners in

Menominee (County) Located In: Corner Code #
Public Land Survey
Property Controlling Section
Miscellaneous Property in Sec.

Lot No. Recorded Plat
Private Claims

Jeremy J. Pipp, in a field survey on 11/04/2013 do hereby state
that under requirements of P.A. 74, Michigan P.A. of 1970, the corner points mentioned in lines 1 and 2
above were in conformance with regulations and rules therefore as required in the current manual of survey
instructions of the United States Department of the Interior, Bureau of Land Management or by a decree of
Court of Law and /or that the corner points mentioned in lines 3, 4 and 5 above were in conformance with
the rules of the Michigan Board of Land Surveyors or by a Decree of a Court of Law; established,
re-established, monumented, recovered, found as expressed below:

NOTE: Not more than 2 corners, all in the same town and range, may be recorded
in this certificate.

1. Description of original monument and accessories and/or subsequent restoration:

(06) Northeast One-Sixteenth corner of Section 1. Not set in original survey, no evidence of
subsequent establishment.

(07) North One-Sixteenth corner common to Sections 12 [T41N-R26W] and 7 [T41N-R25W]. Not set in
original survey, no evidence of subsequent establishment.

3. Description of corner evidence found and/or method applied in restoring or reestablishing corner:

(06) Corner position established at the intersection of the North and East One-Sixteenth lines of
Section 1.

(07) Corner position established mid-point and on-line between the East One-Quarter corner and the
Northeast corner of Section 12.

C. Description of monument for corner and accessories established to perpetuate locating the position of the corner:

(06) DNR monument
11" Maple N27E 6.87' (1/16S,BT)
8" Maple S76E 25.90' (1/16S,BT)
8" Maple S22W 21.95' (1/16S,BT)
9" Maple N54W 21.78' (1/16S,BT)

All trees are blazed, scribed, and
painted. Measurements are to nail in
side of tree, bearings are magnetic.

Signed by [Signature]
Surveyor's Michigan License No. 50447

For the Michigan Department of Natural Resources

(07) DNR monument
12" Cedar N14E 30.61' (1/16S,BT)
21" W. Pine S15E 11.29' (1/16S,BT)
11" Maple S30W 24.65' (1/16S,BT)
11" Cedar N47W 26.20' (1/16S,BT)

All trees are blazed, scribed, and
painted. Measurements are to nail in
side of tree, bearings are magnetic.

Date August 25, 2014

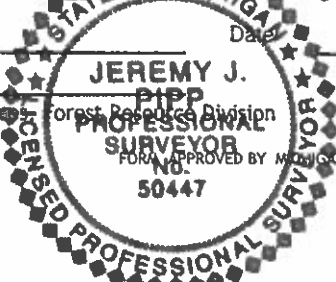


Table with 13 rows and 13 columns (A-M) for Register of Deeds Stamp & File Number.