

LAND CORNER RECORDATION CERTIFICATE
Filing Requirement of Act 74, Mich. P.A. 1970 as Amended

for corners in

<u>Menominee</u> (County)	Located In:	Corner Code #
1. Public Land Survey	T 41N R 26W	F05
	T 41N R 26W	I04
	T _____ R _____	_____
2. Property Controlling Section	S _____ T _____ R _____	_____
	S _____ T _____ R _____	_____
	S _____ T _____ R _____	_____
3. Miscellaneous Property in Sec.	S _____ T _____ R _____	_____
	S _____ T _____ R _____	_____

4. Lot No. _____, Recorded Plat _____

5. Private Claims _____

8/13/2014

Jeremy J. Pipp, in a field survey on 8/12/2014 do hereby state

that under requirements of P.A. 74, Michigan P.A. of 1970, the corner points mentioned in lines 1 and 2 above were in conformance with regulations and rules therefore as required in the current manual of survey instructions of the United States Department of the Interior, Bureau of Land Management or by a decree of Court of Law and /or that the corner points mentioned in lines 3, 4 and 5 above were in conformance with the rules of the Michigan Board of Land Surveyors or by a Decree of a Court of Law; established, re-established, monumented, recovered, found as expressed below:

NOTE: Not more than 2 corners, all in the same town and range, may be recorded on this certificate.

A. Description of original monument and accessories and/or subsequent restoration:

(F05) Quarter corner common to Sections 9 and 16. 1852: E.C. Martin, DS. Set quarter section post witnessed by Cedar 12 S60E 29 links (19.14'), Tamarack 24 N30W 2 links (1.32'). 1955: Michigan DNR (Billy Buckler PS#8887) Set 1" pipe with 4" Brass cap [from original evidence] witnessed by 6" Spruce N17W 29 links (19.14'), 6" Tamarack S43E 42 links (27.72').

(I04) Quarter corner common to Sections 10 and 11. 1852: E.C. Martin, DS. Set quarter section post witnessed by Tamarack 14 S40W 9 links (5.94'), Spruce 6 N65E 35 links (23.10'). 1949: MDNR Forester (Clarence Limpert) noted a "WP" [wood post] at this location.

B. Description of corner evidence found and/or method applied in restoring or reestablishing corner:

(F05) Accepted found MDNR Monument and trace remains of mound at OBT location NW (no remains of VBTs; clear cut SE and all Tamarack NW). Position is accepted as a careful and faithful PERPETUATION of the position of the original corner.

(I04) Accepted found old wood post points [two] (within a foot of calculated single proportionate location calculated from Original locations at section corners North & South). Mound in place of SW Tamarack OBT. Position is accepted as a careful and faithful PERPETUATION of the position of the original corner.


C. Description of monument for corner and accessories established to perpetuate locating the position of the corner:

(F05)	DNR monument	(I04)	DNR monument
5" Tamarack	N12E 11.09' (1/4S,NBT)	7" Cedar	N55E 18.00' (1/4S,NBT)
6" Tamarack	S80E 5.71' (1/4S,NBT)	4" Spruce	S38E 22.70' (1/4S,NBT)
5" Tamarack	S25W 6.63' (1/4S,NBT)	14" Cedar	S81W 20.05' (1/4S,NBT)
5" Tamarack	N79W 9.83' (1/4S,NBT)	12" Cedar	N27W 49.13' (1/4S,NBT)

All trees are blazed, scribed, painted, and signed. Measurements are to nail in side of tree, bearings are magnetic. A Metal sign post was set North 1.5 feet.

All trees are blazed, scribed, painted, and signed. Measurements are to nail in side of tree, bearings are magnetic. A Metal sign post was set North 1.5 feet.

Signed by Jeremy J. Pipp
 Surveyor's Michigan License No. 50447

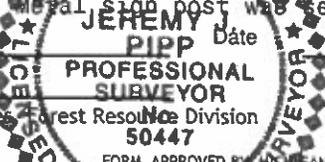

Date August 25, 2014

For the Michigan Department of Natural Resources Forest Resource Division

Register of Deeds Stamp & File Number

	A	B	C	D	E	F	G	H	I	J	K	L	M
1													
2	6		5		4		3		2		1		
3													
4	7		8		9		10		11		12		
5													
6	18		17		16		15		14		13		
7													
8	19		20		21		22		23		24		
9													
10	30		29		28		27		26		25		
11													
12	31		32		33		34		35		36		
13													