

ALSO T42N-R26W I13
ALSO T42N-R26W J13
for corners in

LAND CORNER RECORDATION CERTIFICATE
Filing Requirement of Act 74, Mich. P.A. 1970 as Amended

Menominee

(County)

Located In:

Corner Code #

1. Public Land Survey

T 41N R 26W

T 41N R 26W

T

I01

J01

2. Property Controlling

S

T

R

n Section

S

T

R

3. Miscellaneous

S

T

R

Property in Sec.

S

T

R

4. Lot No. , Recorded Plat
5. Private Claims

8/05/2014
Jeremy J. Pipp, in a field survey on 8/05/2014 do hereby state
that under requirements of P.A. 74, Michigan P.A. of 1970, the corner points mentioned in lines 1 and 2
above were in conformance with regulations and rules therefore as required in the current manual of survey
instructions of the United States Department of the Interior, Bureau of Land Management or by a decree of
a Court of Law and /or that the corner points mentioned in lines 3, 4 and 5 above were in conformance with
the rules of the Michigan Board of Land Surveyors or by a Decree of a Court of Law; established,
re-established, monumented, recovered, found as expressed below:

NOTE: Not more than 2 corners, all in the same town and range, may be recorded
on this certificate.

A. Description of original monument and accessories and/or subsequent restoration:

(I01) Section corner common to Sections 2 [T41N-R26W], 3 [T41N-R26W], 34 [T42N-R26W] and 35 [T42N-R26W]. 1846: John Burt, DS. Set section post witnessed by Sugar 14 N40E 23 links (15.18'), Sugar 14 N35W 22 links (14.52'). 1962: Kimberly Clark (Neal Sperhake PS#7876) Set 1" pipe with 4" Aluminum cap by proportionate method witnessed by Maple 4 N60E 29.5 links (19.47'), Maple 5 S61E 27.5 links (18.15'), Ironwood 7 S65W 72 links (47.52') Hemlock 14 N07W 36.5 links (24.09').

(J01) Quarter corner common to Sections 2 [T41N-R26W] and 35 [T42N-R26W]. 1846: John Burt, DS. Set quarter section post witnessed by Fir 8 N20E 27 links (17.82'), Lynn 10 N79W 20 links (13.20'). 1962: Kimberly Clark (Neal Sperhake PS#7876) Set 1" pipe with 4" Aluminum cap by proportionate method witnessed by Maple 7 N25E 40.5 links (26.73'), Cedar 7 S08W 77 links (50.82').

3. Description of corner evidence found and/or method applied in restoring or reestablishing corner:

(I01) Accepted found Kimberly Clark Monument and Three NBT Witnesses (Ironwood has been cut, now a stump). Position is accepted as a careful and faithful REESTABLISHMENT of the position of the original corner.

(J01) Accepted found Kimberly Clark Monument and Two NBT Witnesses (Cedar living, Maple stump mound). Position is accepted as a careful and faithful REESTABLISHMENT of the position of the original corner.

C. Description of monument for corner and accessories established to perpetuate locating the position of the corner:


(I01) Kimberly Clark monument
EX 12" Maple N63E 19.61' (- , -)
EX 12" Maple S58E 17.84' (- , -)
9" Maple S71W 36.98' (S3,NBT)
EX 21" Hemlock N05W 24.53' (- , -)

All trees are blazed, scribed, painted, and signed. Measurements are to nail in side of tree, bearings are magnetic. A Metal sign post was set South 1.5 feet.

Signed by
Surveyor's Michigan License No. 50447
For the Michigan Department of Natural Resources

(J01) Kimberly Clark monument
8" Cedar N51E 9.73' (1/4S,NBT)
7" Maple S74E 9.80' (1/4S,NBT)
EX 15" Cedar S14W 50.93' (1/4S,NBT)
15" Cedar N87W 36.46' (1/4S,NBT)
All trees are blazed, scribed, painted, and signed. Measurements are to nail in side of tree, bearings are magnetic. A Metal sign post was set South 1.5 feet.

Date August 25, 2014

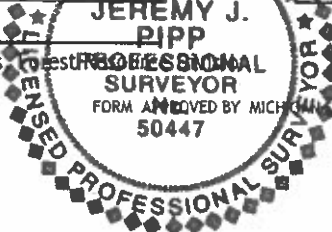

Register of Deeds Stamp & File Number												
A	B	C	D	E	F	G	H	I	J	K	L	M
1												
2	6		5		4		3		2		1	
3												
4	7		8		9		10		11		12	
5												
6	18		17		16		15		14		13	
7												
8	19		20		21		22		23		24	
9												
10	30		29		28		27		26		25	
11												
12	31		32		33		34		35		36	
13												