

LAND CORNER RECORDATION CERTIFICATE
Filing Requirement of Act 74, Mich. P.A. 1970 as Amended

for corners in

Menominee Located In: Corner Code #
1. Public Land Survey T 41N R 26W K02
T 41N R 26W L03
2. Property Controlling S T R
n Section S T R
3. Miscellaneous S T R
Property in Sec. S T R

4. Lot No. , Recorded Plat
5. Private Claims

10/29/2013
Jeremy J. Pipp, in a field survey on 10/29/2013 do hereby state
that under requirements of P.A. 74, Michigan P.A. of 1970, the corner points mentioned in lines 1 and 2
above were in conformance with regulations and rules therefore as required in the current manual of survey
instructions of the United States Department of the Interior, Bureau of Land Management or by a decree of
Court of Law and /or that the corner points mentioned in lines 3, 4 and 5 above were in conformance with
the rules of the Michigan Board of Land Surveyors or by a Decree of a Court of Law; established,
re-established, monumented, recovered, found as expressed below:

NOTE: Not more than 2 corners, all in the same town and range, may be recorded
on this certificate.

A. Description of original monument and accessories and/or subsequent restoration:

(K02) Quarter corner common to Sections 1 and 2. 1852: E.C. Martin, DS. Set quarter section post
witnessed by Tamarack 4 S27W 22 links (14.52'), Tamarack 4 N28E 32 links (21.12'). No evidence
of subsequent establishment.

(L03) Quarter corner common to Sections 1 and 12. 1852: E.C. Martin, DS. Set quarter section post
witnessed by Cedar 14 S50W 24 links (15.84'), Cedar 12 N58E 30 links (19.80'). No evidence of
subsequent establishment.

B. Description of corner evidence found and/or method applied in restoring or reestablishing corner:

(K02) No evidence of original survey. Corner position reestablished by single proportionate
measurement between the Northwest corner and the Southwest corner of Section 1. Position is
accepted as a careful and faithful REESTABLISHMENT of the position of the original corner.

(L03) No evidence of original survey. Corner position reestablished by single proportionate
measurement between the Southwest corner and the Southeast corner of Section 1. Position is
accepted as a careful and faithful REESTABLISHMENT of the position of the original corner.

C. Description of monument for corner and accessories established to perpetuate locating the position of the corner:


(K02) DNR monument (L03) DNR monument
3" B. Spruce N20E 6.51' (1/4S,NBT) 8" Tamarack East 12.47' (1/4S,NBT)
3" B. Spruce S25E 8.50' (1/4S,NBT) 10" Cedar S38E 44.63' (1/4S,NBT)
4" B. Spruce S84W 11.72' (1/4S,NBT) 6" Tamarack N14W 2.12' (1/4S,NBT)
5" Tamarack N46W 44.90' (1/4S,NBT) 10" Cedar N77W 29.43' (1/4S,NBT)
All trees are blazed, scribed, painted, and signed. Measurements are to nail in
side of tree, bearings are magnetic. A Metal sign post was set North 1.5 feet.
Signed by Date August 25, 2014

Surveyor's Michigan License No. 50447

For the Michigan Department of Natural Resources, Forest Restoration

20411

20410

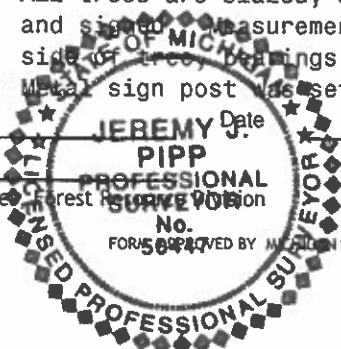

Register of Deeds Stamp & File Number

	A	B	C	D	E	F	G	H	I	J	K	L	M
1													
2	6		5		4		3		2		1		
3													
4	7		8		9		10		11		12		
5													
6	18		17		16		15		14		13		
7													
8	19		20		21		22		23		24		
9													
10	30		29		28		27		26		25		
11													
12	31		32		33		34		35		36		
13													