

MICHIGAN
DEPARTMENT OF CONSERVATION
FORESTRY DIVISION

LAND CORNER RECORD

T. 21 N. R. 5 W.


Missaukee COUNTY

DESCRIPTION OF CORNER Section corner common to Sections 1-2-11-12

CORNER MONUMENT Left 1 1/2" pipe in place

DATE MONUMENT PLACED AND WITNESSED 10/17/61

WITNESSES TO CORNER.....

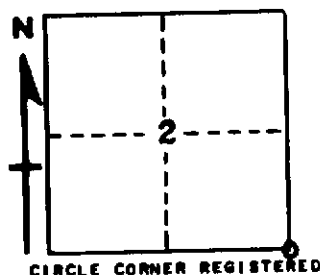

8" Maple	-	N1W	-	22.9 feet
7" Ash	-	S35W	-	25.9 feet
AND 9" Elm	-	S47E	-	28.4 feet

DESCRIPTION IN DETAIL AS TO HOW CORNER WAS LOCATED AND IDENTIFIED OR RESTORED.

This corner was found while making a survey of Section 2. Found 1 1/2" pipe in place on south edge of E-W grade, as previously established by Marcus Schaaf, RLS, in 1938 survey of this township. One government BT stump showing possible evidence in place NW.

SURVEYOR'S SEAL

SIGNED Kenneth J. Ostling DATE 10/17/61
REGISTERED LAND SURVEYOR