

LAND CORNER RECORDATION CERTIFICATE  
Filing Requirement of Act 74, Mich. P.A. 1970

For corners in  
MISSAUKEE  
(County)

Located In:

Corner Code ≠

1. Public Land Survey T 21N R 5W F-13, 6-12  
T      R            
T      R            
T      R
2. Property Controlling S 34 T      R      10  
in Section S      T      R
3. Miscellaneous S      T      R            
Property in Sec. S      T      R

Register of Deeds Stamp & File Number

4. Lot No.     , Recorded Plat
5. Private Claims

I, CARL F. ROSER, in a field survey on FEBRUARY 20, 19 90,  
do hereby certify that under requirements of P.A. 74, Michigan P.A. of 1970, the corner points mentioned  
in lines 1 and 2 above were in conformance with regulations and rules therefore as required in the  
current manual of survey instructions of the United States Department of the Interior, Bureau of Land  
Management or by a decree of a Court of Law and/or that the corner points mentioned in lines 3, 4 and 5  
above were in conformance with the rules of the Michigan Board of Land Surveyors or by a Decree of a  
Court of Law; established, re-established, monumented, re-monumented, recovered, found as  
expressed below:

NOTE: Not more than 4 corners, all in the same town and range, may be recorded  
on this certificate.

A. Description of original monument and accessories and/or subsequent restoration:


F-13 6-12 10

B. Description of corner evidence found and/or method applied in restoring or reestablishing corner:

F-13	6-12	10
ACCEPTED FD 2" BLACK PIPE FOR 8 1/4 COR SEC 33. COR FALLS IN TAG ALDER SWAMP, 48'± E OF WEST EDGE OF SWAMP. COR FITS 1938 M. SCHAAF DIST W TO CLOSING COR TO SEC 8 4 & 5 & DIST E TO BE SEC 33. SCHAAF NOTES SAYS HE HAD USBT (Y PINE STP) NE.	ESTABLISHED W 1/4 COR SEC 34 MIDWAY AND ON LINE BETWEEN SEC CORNERS 1/2 MILE N & S. COR FALLS 1/2'± EAST OF CTR OF N-S B.TOP ROAD.	DROVE 5/8" REROD FOR SW COR OF NW 1/4 OF SW 1/4 OF SEC 34. COR SET PER STANDARD BLM INSTRUCTIONS. COR FALLS 1' W OF CTR N-S BIT RD, AT N END OF LONG CURVE.

C. Description of monument for corner and accessories established to perpetuate locating the position of the corner:

F-13	6-12	10
DROVE 1" X 4' GALV PIPE W/ALUM DNR CAP IN FD 2" PIPE; SET CED POST. 4" TW MAPLE N30°W 21.7' 13" MAPLE S20°W 35.2' 15" DAK S40°W 38.9' 10" MAPLE DUE W 51.9'	DROVE 5/8" X 17" REROD W/RLS CAP. 15" W PINE N60°E 59.5' 7" MAPLE S45°E 55.9' 6" MAPLE (CLP 3) S45°W 61.6' SET CED POST W/ LOC TAG. DUE E 33'	DROVE 5/8" X 17" REROD W/RLS CAP. 15" W DAK N70°E 59.4' 10" DAK S80°E 72.3' 8" W DAK S40°W 79.6' SET CED POST W/ LOC TAG. DUE E 33'

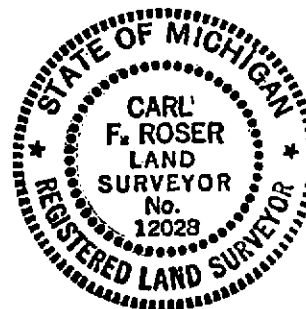

Signed by Carl F. Roser 5-22-92

Date     

Surveyor's Michigan License No. 12028