

JAN 19 2000

SECTION

LIBER 333 PAGE 434

LAND CORNER RECORDATION CERTIFICATE  
Filing Requirement of Act 74, Mich. P.A. 1970

#1346

For corners in

Missaukee County	Located In:	Corner Code #
1. Public Land Survey	T 21N R 06W	M-2
	T R	
	T R	
	T R	
2. Property Controlling in Section	S T R	
	S T R	
3. Miscellaneous Property in Sec.	S T R	
	S T R	

MISSAUKEE COUNTY MICHIGAN

RECORDED DEC 09 1999

Carolyn Klare

Register of Deeds Stamp & File Number

4. Lot No. , Recorded Plat

5. Private Claims

I, J. Dean Geers, P.S., in a field survey on June, 19 99 do hereby state that under requirements of P.A. 74, Michigan P.A. of 1970, the corner points mentioned in lines 1 and 2 above were in conformance with regulations and rules therefore as required in the current manual of survey instructions of the United States Department of the Interior, Bureau of Land Management or by a decree of a Court of Law and /or that the corner points mentioned in lines 3, 4 and 5 above were in conformance with the rules of the Michigan Board of Land Surveyors or by a Decree of a Court of Law; established, re-established, monumented, recovered, found as expressed below:

NOTE: Not more than 2 corners, all in the same town and range, may be recorded on this certificate.

	A	B	C	D	E	F	G	H	I	J	K	L	M
1													
2	6			5		4		3		2		1	
3													
4	7			8		9		10		11		12	
5													
6	18			17		16		15		14		13	
7													
8	19			20		21		22		23		24	
9													
10	30			29		28		27		26		25	
11													
12	31			32		33		34		35		36	
13													

A. Description of original monument and accessories and/or subsequent restoration:

- M-2) 1837 GLO Quarter Section Post by John Brink, Deputy Surveyor. 10" Beech-S46W-25 lks, 10" Beech-N44W-23 lks.  
M-2) 1907 McBain survey; Corner witnesses, WPS 24"-S44W-22 lks, WPS 22"-S52½W-27 lks.  
M-2) 1987 Roser survey and LCRC, Liber 1, Page 742; Set DNR monument and Cedar post. 10" Oak-S76E-37.1', 4" Oak-S86W-63.2', 2" Maple-S50E-21.0', Set corner at pro-rated distance to GLO.

B. Description of corner evidence found and/or method applied in restoring or reestablishing corner:


- M-2) Quarter section corner common to Section 1, T21N, R6W and Section 6, T21N, R5W. Found DNR monument and cedar location post as recorded in Liber 1, Page 742. This corner is accepted as a careful and faithful re-establishment of the position of the original corner.

C. Description of monument for corner and accessories established to perpetuate locating the position of the corner:

M-2) Found DNR Monument

- |       |        |  |
|-------|--------|--|
| S10E  | 2.27'  | Set nail in west face of corner fence post |
| N10E  | 4.70'  | Set nail in west face of fence post        |
| S66E  | 38.21' | Set nail in north face of 3" birch         |
| N83W  | 62.99' | Set nail in south face of 2" maple clump   |
| N42W  | 61.20' | Set nail in south face of 5" oak           |
| *S50E | 20.7'  | Maple stump                                |
| *S73E | 37.6'  | Oak stump                                  |

\*Previous Witness

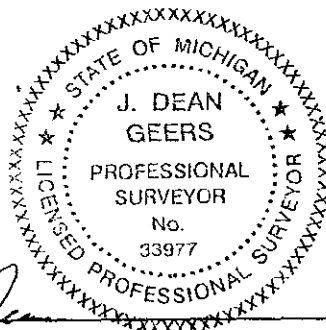

Peer Group Reviewed and Approved

Date: 12-9-99  
J. Dean Geers, Missaukee Co. Representative

Signed by

Surveyor's Michigan License No. 33977

Date 11-23-99