

JAN 19 2000

LIBER 333 PAGE 453

SECTION

LAND CORNER RECORDATION CERTIFICATE

Filing Requirement of Act 74, Mich. P.A. 1970

For corners in

Missaukee County
(County)

Located In:

Corner Code #

1. Public Land Survey T 21N R 8W G - 11
T R
T R
T R
2. Property Controlling S T R
in Section S T R
3. Miscellaneous S T R
Property in Sec. S T R

4. Lot No. , Recorded Plat
5. Private Claims

MISSAUKEE COUNTY MICHIGAN

RECORDED DEC 09 1999 4:10 PM

Register of Deeds Stamp & File Number

I, Daniel E. Schripsema, in a field survey on October 1, 1999 do hereby state that under requirements of P.A. 74, Michigan P.A. of 1970, the corner points mentioned in lines 1 and 2 above were in conformance with regulations and rules therefore as required in the current manual of survey instructions of the United States Department of the Interior, Bureau of Land Management or by a decree of a Court of Law and /or that the corner points mentioned in lines 3, 4 and 5 above were in conformance with the rules of the Michigan Board of Land Surveyors or by a Decree of a Court of Law; established, re-established, monumented, recovered, found as expressed below:

NOTE: Not more than 2 corners, all in the same town and range, may be recorded on this certificate.

A. Description of original monument and accessories and/or subsequent restoration:

G-11 - GLO - Set Post

- Beech 9" S.27 1/2 W.28 ; Beech 14" N. 80 E.21
- Co. Surveyor Notes - Book 36, Page 55 - May 7, 1894
- Hemlock 20" N.46 1/2 W.43 ; Sugar 12" S. 26 1/2 E.26
- Record Survey - L. S-2, Page 378 - James A. Ray - March 27, 1987
- LCRC #816 - James A. Ray - Jan. 20, 1990 - Found 1/2" Iron in Intersection
- N55W 24" Stump 66.54 ; S40W Rd. Sign 42.9 ; S25E 7" Elm 68.67 ; N50E 30" Maple 42.92
- Record Survey - L. S-3, Page 422 - Craig J. Pullen - Jan. 16, 1997
- Daniel E. Schripsema - Job No. 98160 - Nov. 25, 1998
- 36" Maple N65E 42.79 ; P. Pole S47W 44.61 ; 10" Elm S80E 68.71 ; 30" Maple N25E 111.15

B. Description of corner evidence found and/or method applied in restoring or reestablishing corner:


Found a bent 1/2" bar below pole barn spike, it is located approximately 1' North of centerline of E-W road and in centerline of N-S road. This corner is accepted as the best available evidence of the position of the original corner.

C. Description of monument for corner and accessories established to perpetuate locating the position of the corner:

Set Missaukee County Monument on top of iron.

WITNESSES

N65E 42.18' 36" Maple
N25E 110.18' 30" Maple
S10E 68.66' 16" Elm
S47W 44.55' Power Pole
S52W 42.90' Road Sign

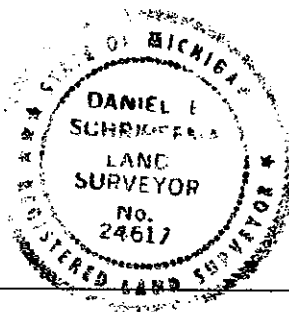

Peer Group Reviewed and Approved

Date: 12-9-99
J. Dean Geers, Missaukee Co. Representative

Signed by Daniel E. Schripsema
Surveyor's Michigan License No. _____

Date 12-21-99